

Jackson
 N 273
 4-23-70

MISSISSIPPI
 BOARD OF WATER COMMISSIONERS
 416 North State Street
 Jackson, Mississippi 39201

CODED

WATER WELL DRILLERS LOG

April 23 1970 L. S. Garland water wells Jackson
 (date well completed) (firm name) (county well located)


LANDOWNER: <u>Tom Stennis</u>	description of formations encountered		from	to
<u>399 magnnis</u>				
<u>Olean Springs, miss</u> (mailing address)				
WELL LOCATION:				
sec <u>28</u> T <u>7</u> N R <u>9</u> E <u>3 1/2</u> miles <u>east</u> of <u>P.S.</u> (distance) (direction) (nearest town)				
WELL PURPOSE: <u>farmhouse, warehouse</u> (home, irrigation, municipal, industrial)				
WELL COMPLETION DATA:				
(1) diameter (inches) <u>2</u>				
(2) total depth (feet) <u>504</u>				
(3) static water level (feet) <u>24</u> <u>below</u> top of ground.				
(4) casing <u>steel</u> , <u>494</u> , (material) (depth)				
<u>2</u> If telescope see back. (size)				
(5) screen <u>18 ft</u> , <u>494</u> (length) (depth to top)				
<u>2</u> , <u>stainless steel</u> (size) (material)				
(6) pump _____ (HP) _____ (gpd gpm)				
<u>no pump</u> (type power)				
(7) electric log _____ (yes or no)				
_____ (organization running log)				
(8) how well bottom plugged _____				
<u>back wash valve</u>				
DRILLERS REMARKS:				
<u>46 ft water bearing sand</u>				

MAY 7 1970

MISS. Bd. of WATER COMM.

If well telescopes please sketch and show depths.

GROUND LEVEL

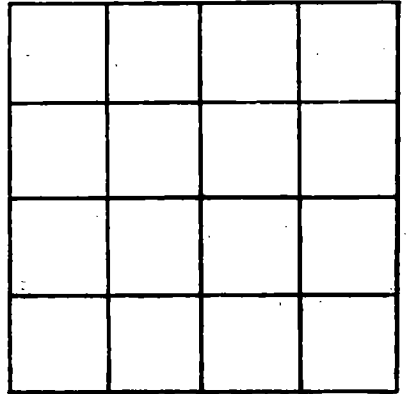

SECTION _____

Please indicate well location X.

ADDITIONAL INFORMATION

If more than one screen, show locations of each on sketch.