

JACKSON
 N ~~208~~ 278
 5-23-69

City at 30 72 24 for C...
 MISSISSIPPI

BOARD OF WATER COMMISSIONERS
 416 North State Street
 Jackson, Mississippi 39201

CODED

WATER WELL DRILLERS LOG

5-23 1969 Dutton Well Works Jackson
 date well completed firm name county well located
now Waterworks

LANDOWNER: LOUIS FAYARD
Ocean Springs, Miss.
Suburban Utilities
 (mailing address)

description of formations encountered	from	to
Surface sand	0	8
sand & clay	8	18
yellow sand	18	89
clay	89	416
sand	416	499

WELL LOCATION:
 $\frac{18}{18}$ $\frac{18}{18}$ T 7 x R 8 E
 S W
 18 miles N of Ocean Springs
 (distance) (direction) (nearest town)

WELL PURPOSE: sub-dimension
 (home, irrigation, municipal, industrial)

WELL COMPLETION DATA:

(1) diameter (inches) 12 x 8"

(2) total depth (feet) 499'

(3) static water level (feet) 16' below above top of ground.

(4) casing Black steel, 439'
 (material) (depth)
8 x 12 if telescope see back.
 (size)

(5) screen 60', 439'
 (length) (depth to top)
8", stainless steel
 (size) (material)

(6) pump 30 400
 (HP) (yield gpm)
elec
 (type power)

(7) electric log no
 (yes or no)

(organization running log)

(8) how well bottom plugged B.P. Value


CODED

DRILLERS REMARKS:

Feb.
~~1972~~ 2 - 1971

MISS. BD. OF
 WATER COM.

If well telescopes please
sketch and show depths.

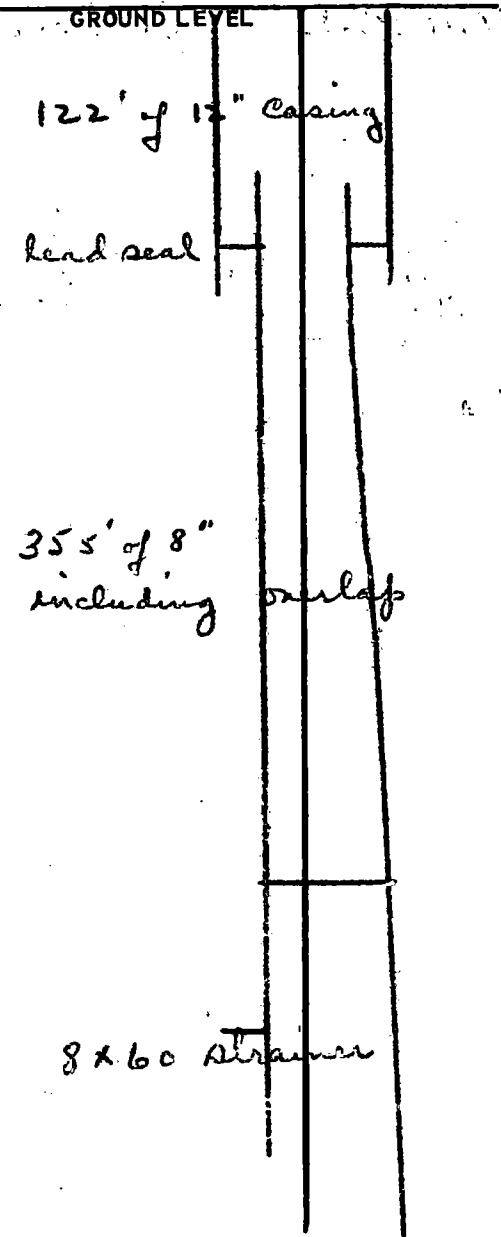

		X	

SECTION 19

Please indicate well location X.

ADDITIONAL INFORMATION

Lined area for additional information.

If more than one screen,
show locations of each on sketch.