

JACKSON  
 N 280  
 7-15-70

MISSISSIPPI  
 BOARD OF WATER COMMISSIONERS  
 416 North State Street  
 Jackson, Mississippi 39201

**CODED**

WATER WELL DRILLERS LOG

JACKSON  
 Harrison

7-15-70 To C.T. Switzer Well Co. date well completed firm name county well located

LANDOWNER: David Goff  
Cherokee Road  
Biloxi, Miss.  
 (mailing address)

WELL LOCATION:  
 sec. 15 T. 7 S. R. 9 E. W.  
1.5 miles N of BILOXI  
 (distance) (direction) (nearest town)

WELL PURPOSE: Home  
 (home, irrigation, municipal, industrial)

WELL COMPLETION DATA:

- (1) diameter (inches) 2"
- (2) total depth (feet) 415'
- (3) static water level (feet) 20' below  
 top of ground.
- (4) casing galv. 415'  
 (material) (depth)  
         If telescope see back.  
 (size)
- (5) screen 10' 405'  
 (length) (depth to top)  
006 Stainless steel  
 (size) (material)
- (6) pump 1/2 5.5  
 (HP) (yield gpm)
- ELEC.  
 (type power)
- (7) electric log NO  
 (yes or no)
- (organization running log)

(8) how well bottom plugged back  
pressure valve

| description of formations encountered | from | to  |
|---------------------------------------|------|-----|
| CLAY                                  | 1    | 14  |
| SAND                                  | 14   | 25  |
| CLAY                                  | 25   | 75  |
| SAND                                  | 75   | 80  |
| CLAY                                  | 80   | 100 |
| MIXED                                 | 100  | 139 |
| CLAY                                  | 139  | 179 |
| MIXED                                 | 179  | 199 |
| CLAY                                  | 199  | 216 |
| SAND                                  | 216  | 238 |
| CLAY                                  | 238  | 396 |
| SAND, extra-fine                      | 396  | 415 |

**CODED**


SEP 11 1970

DRILLERS REMARKS:

MISS. BD. OF  
 WATER COM.

If well telescopes please sketch and show depths.

GROUND LEVEL

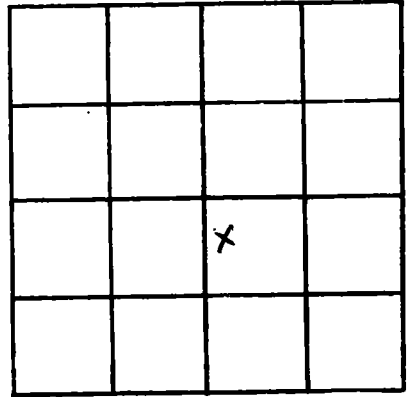

SECTION 15

Please indicate well location X.

ADDITIONAL INFORMATION

If more than one screen,  
show locations of each on sketch.