

MISSISSIPPI
BOARD OF WATER COMMISSIONERS
416 North State Street
Jackson, Mississippi 39201

CODED

WATER WELL DRILLERS LOG

JACKSON
N 281
6-5-70

6-5 1970 *Coast Water Well Service* *Darlington*
date well completed firm name county well located



LANDOWNER:	description of formations encountered	from	to
<i>Paul Omas</i>			
<i>Rt. 3 Box 366</i>	<i>Surface Soil</i>	<i>0</i>	<i>22</i>
<i>Ocean Springs, Miss.</i> (mailing address)	<i>Blue Clay</i>	<i>22</i>	<i>42</i>
WELL LOCATION:	<i>Sand - med. to coarse</i>	<i>42</i>	<i>126</i>
sec. <i>24</i> T. <i>7</i> N. R. <i>8</i> W.	<i>Blue Clay</i>	<i>126</i>	<i>350</i>
<i>3.5</i> miles <i>E</i> of <i>Ocean Springs</i>	<i>Sand - med. to coarse</i>	<i>350</i>	<i>400</i>
(distance) (direction) (nearest town)			
WELL PURPOSE:			
<i>Water Park</i> (home, irrigation, municipal, industrial)			
WELL COMPLETION DATA:			
(1) diameter (inches) <i>4" X 2"</i>			
(2) total depth (feet) <i>400</i>			
(3) static water level (feet) <i>19</i> below top of ground.			
(4) casing <i>galv.</i> material, <i>380'</i> (depth)			
<i>4" X 2"</i> (size) If telescope see back.			
(5) screen <i>20'</i> (length) <i>380'</i> (depth to top)			
<i>2"</i> (size) <i>Stainless Steel</i> (material)			
(6) pump <i>3/4" Sub.</i> (HP) <i>36</i> (yield gpm)			
<i>elec.</i> (type power)			
(7) electric log <i>N/O</i> (yes or no)			
(organization running log)			
(8) how well bottom plugged <i>Backwash Valve</i>			
DRILLERS REMARKS:			

CODED

SEP 18 1970

MISS. BR. OF
WATER COMMISSIONERS

If well telescopes please sketch and show depths.

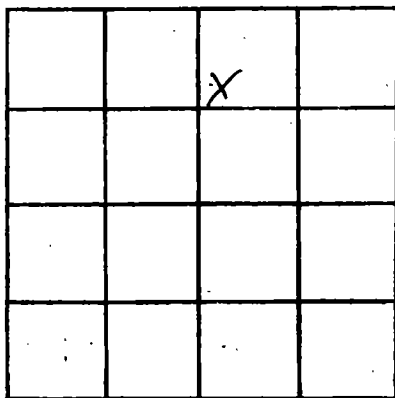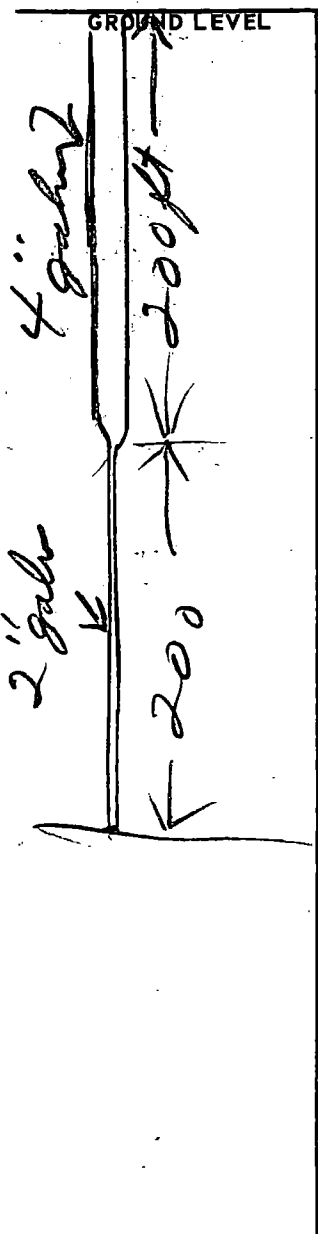

SECTION 24

Please indicate well location X.

ADDITIONAL INFORMATION

If more than one screen, show locations of each on sketch.