

JACKSON  
 N285  
 8-3-70

MISSISSIPPI  
 BOARD OF WATER COMMISSIONERS  
 416 North State Street  
 Jackson, Mississippi 39201

**CODED**

WATER WELL DRILLERS LOG

August 3 1970 L. L. Garland water wells Jackson.  
 date well completed firm name county well located

LANDOWNER:

A. D. Johnson

description of formations encountered

from to

P.O. Box Ocean Springs, Miss.  
 (mailing address)

WELL LOCATION:

sec 9 T 7 N R 8 E  
 (distance) (direction) (nearest town)  
 4 miles N.E. of Ocean Springs

WELL PURPOSE: home  
 (home, irrigation, municipal, industrial)

WELL COMPLETION DATA:

- (1) diameter (inches) 2
- (2) total depth (feet) 400
- (3) static water level (feet) 25 below top of ground
- (4) casing steel, 390 (material), (depth)  
 2 (size) if telescope see back.
- (5) screen 10 ft (length), 390 (depth to top)  
 2 (size), stainless steel (material)
- (6) pump 1/2 (HP), 550 gallons per hr (yield gpm)  
 electric (type power)
- (7) electric log (yes or no)

**CODED**

(organization running log)

AUG 7 1970

(8) how well bottom plugged  
 pack wash, talc


MISS. Bd. OF  
 WATER COMMISSIONERS

DRILLERS REMARKS:

47 ft.  
 water bearing sand

If well telescopes please sketch and show depths.

GROUND LEVEL

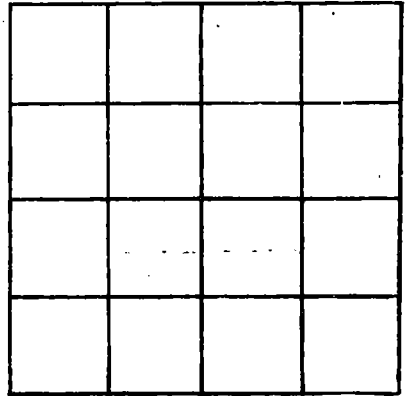

SECTION \_\_\_\_\_

Please indicate well location X.

ADDITIONAL INFORMATION

If more than one screen, show locations of each on sketch.