

JACKSON  
N286

8-28-70

MISSISSIPPI  
BOARD OF WATER COMMISSIONERS  
416 North State Street  
Jackson, Mississippi 39201

**CODED**

WATER WELL DRILLERS LOG

8-28 1970 M+B Drilling Co Jackson  
date well completed firm name county well located

LANDOWNER: Noel Wells  
1111 Bolen Ave  
Ocean Springs, Miss.  
(mailing address)

description of formations encountered	from	to
Surface	0	10
White Grey Clay	10	20
Sand - white	20	35
Sand & Clay Breaks	35	50
Blue Clay	50	100
Sand	100	115
Blue Clay	115	213
Sand - Grey	213	227
Blue Clay	227	232 1/2

WELL LOCATION:  
sec. 11 T 7 S R 9 W  
2 miles E of DeBerville  
(distance) (direction) (nearest town)

WELL PURPOSE: Home  
(home, irrigation, municipal, industrial)

WELL COMPLETION DATA:

(1) diameter (inches) 2"

(2) total depth (feet) 230

(3) static water level (feet) 25 below top of ground.

(4) casing PVC, Total  
(material) (depth)  
(size) if telescope see back.

(5) screen 9ft, 220  
(length) (depth to top)  
2" PVC Sand Pack  
(size) (material)

(6) pump 3/4 10  
(HP) (yield gpm)  
110V 1φ  
(type power)

(7) electric log No  
(yes or no)

(organization running log)

(8) how well bottom plugged  
2" PVC Cap.

**CODED**


OCT 13 1970

MISS. BD. OF  
WATER COMM.

DRILLERS REMARKS:

If well telescopes please sketch and show depths.

GROUND LEVEL

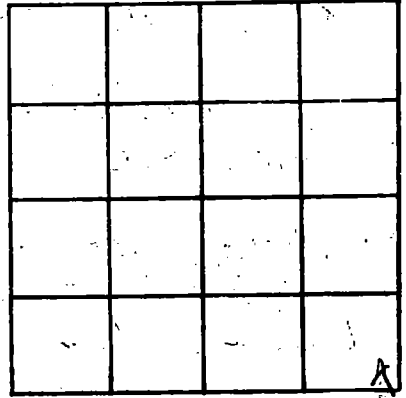

SECTION 17

Please indicate well location X.

ADDITIONAL INFORMATION

If more than one screen, show locations of each on sketch.