

JACKSON

N287

8-30-70

MISSISSIPPI  
 BOARD OF WATER COMMISSIONERS  
 416 North State Street  
 Jackson, Mississippi 39201

**CODED**

WATER WELL DRILLERS LOG

8-30

date well completed

1970 M & B Drilling Co.

firm name

Jackson

county well located

LANDOWNER:

Chester Tackett

Old Highway 90 - Ocean Springs  
(mailing address)

description of formations encountered

from

to

Surface

0

6

reshite clay

6

24

Soft Grey Clay

24

90

Sand

90

96

Blue clay

96

115

Light Grey Clay

115

170

Blue Clay + Sand Bed

170

205

Light Blue Clay

205

233

Grey Sand

233

262

Blue Clay

262

270+

WELL LOCATION:

sec. 2 T. 7 N. R. 9 S. W. 3 miles NW of Ocean Springs (nearest town)

WELL PURPOSE: Home (home, irrigation, municipal, industrial)

WELL COMPLETION DATA:

- (1) diameter (inches) 2
- (2) total depth (feet) 270
- (3) static water level (feet) 15 below above top of ground.
- (4) casing PVC Total (material) (depth)
- 2" If telescope see back. (size)
- (5) screen 9 FT 253 (length) (depth to top)
- 2" PVC Sand Pack (size) (material)
- (6) pump 1 HP 14 (HP) (yield gpm)
- 220 V 1Ø (type power)
- (7) electric log No (yes or no)

**CODED**

OCT 13 1970


MISS. BD OF WATER COMM.

DRILLERS REMARKS:

2" PVC Cap

If well telescopes please sketch and show depths.

GROUND LEVEL

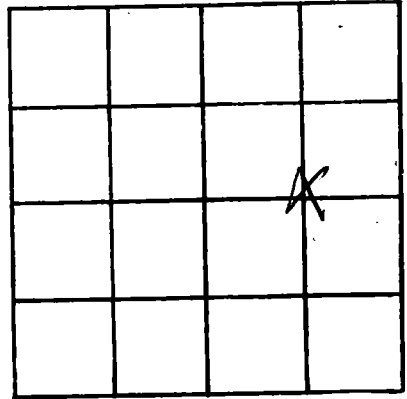

SECTION 2

Please indicate well location X.

ADDITIONAL INFORMATION

If more than one screen, show locations of each on sketch.