

Plugged and Abandoned

3/17/06 by Lyman Well

MISSISSIPPI
BOARD OF WATER COMMISSIONERS
416 North State Street
Jackson, Mississippi 39201

CODED

JACKSON
N 295
11-27-70

WATER WELL DRILLERS LOG

Nov 27 1970 Colville Water Supply Jackson
date well completed firm name county well located

LANDOWNER:	description of formations encountered	from	to
<u>St. Martin East Elementary School</u> <u>Ocean Springs, Miss</u> (mailing address)	<u>surface casing</u> <u>gravel</u> <u>soft blue clay</u> <u>sand</u> <u>clay</u> <u>sand</u> <u>clay</u> <u>sand</u>	<u>0</u> <u>15</u> <u>26</u> <u>71</u> <u>105</u> <u>118</u> <u>462</u> <u>748</u>	<u>15</u> <u>26</u> <u>71</u> <u>105</u> <u>118</u> <u>462</u> <u>748</u> <u>775</u>
WELL LOCATION: sec. <u>7</u> T. <u>2</u> N. R. <u>8</u> E <u>3</u> miles <u>North</u> of <u>Ocean Springs</u> (distance) (direction) (nearest town)			
WELL PURPOSE: <u>School</u> (home, irrigation, municipal, industrial)			
WELL COMPLETION DATA: (1) diameter (inches) <u>4 x 3</u> (2) total depth (feet) <u>887</u> (3) static water level (feet) <u>30</u> <u>below</u> above top of ground. (4) casing <u>Galv</u> (material) (depth) _____ (size) _____ If telescope see back. (5) screen <u>40'</u> <u>847</u> (length) (depth to top) <u>3"</u> <u>Stainless</u> (size) (material) (6) pump <u>5</u> <u>60 GPM at 40 PS</u> (HP) (yield gpm) (type power) <u>elec</u> (7) electric log <u>No</u> (yes or no) (organization running log) _____ (8) how well bottom plugged <u>BP Valve</u>			
DRILLERS REMARKS:			


CODED

JAN 25 1971

MISS. BD OF WATER COMM.

If well telescopes please sketch and show depths.

GROUND LEVEL

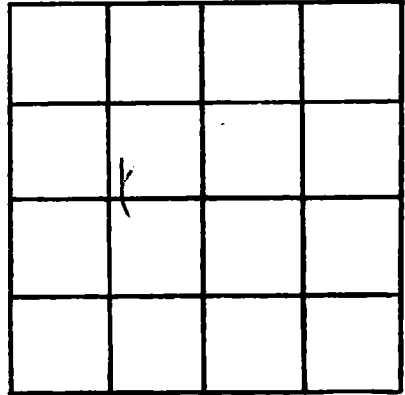

SECTION 2

Please indicate well location X.

ADDITIONAL INFORMATION

A series of horizontal lines for providing additional information.

If more than one screen, show locations of each on sketch.