

JACKSON
N 296
1-8-71

MISSISSIPPI
BOARD OF WATER COMMISSIONERS
416 North State Street
Jackson, Mississippi 39201

CODED

WATER WELL DRILLERS LOG

1-8-71 19
date well completed

P. V. Moore
firm name

JACKSON
county well located

LANDOWNER: DAVID GLAZIER

description of formations encountered

from

to

822 Lee St Biloxi Miss

(mailing address)

WELL LOCATION:

127 sec T 27 N R 9 E
of Gulf Hills (nearest town)
2 miles N (direction)
(distance)

TOP Soil	0	8
White Sand	8	14
White Clay	14	30
Blue Clay	30	190
Silty Sand	190	205
Blue Clay	205	320
Blue Sand	320	325
Blue Clay	325	430
gray Sand	430	472

WELL PURPOSE:

(home, irrigation, municipal, industrial)

WELL COMPLETION DATA:

- (1) diameter (inches) 2"
- (2) total depth (feet) 472'
- (3) static water level (feet) 10' ^{below} _{above} top of ground.
- (4) casing 2 1/2" (material) 460' (depth)
(size) If telescope see back.
- (5) screen 2 1/2" (length) 460' (depth to top)
2" (size) SS (material)
- (6) pump 1 (HP) 8 (yield gpm)
E. Oct (type power)
- (7) electric log (yes or no)
(organization running log)
- (8) how well bottom plugged Bad

CODED


FEB 2 1971

DRILLERS REMARKS:

MISS. BD. OF
WATER COMMISSIONERS

If well telescopes please sketch and show depths.

GROUND LEVEL

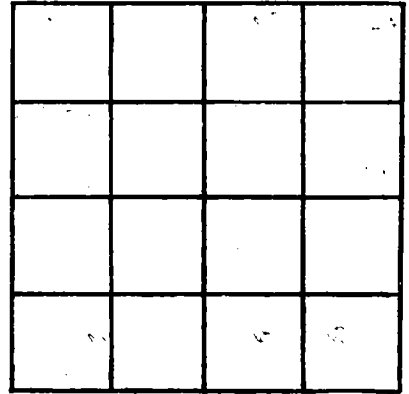

SECTION _____

Please indicate well location X.

ADDITIONAL INFORMATION

If more than one screen,
show locations of each on sketch.