

# CODED

MISSISSIPPI  
BOARD OF WATER COMMISSIONERS  
416 North State Street  
Jackson, Mississippi 39201

FEB 16 1971  
MISS. BD. OF  
WATER COMM.

## WATER WELL DRILLERS LOG

JACKSON  
N299  
12-2-70

12-2-70 date well completed      1970 Const Water Well Dr. firm name      Jackson county well located

LANDOWNER: J. L. Seawell  
P.O. Box 689  
Ocean Springs, Miss.  
(mailing address)

description of formations encountered	from	to
top soil + sand	0	157
clay - shells + sand streaks	157	400
fine sand	400	419
blue clay + sand streaks	419	504
sand - fine to med.	504	556

WELL LOCATION:  
sec. 10 T. 8 S. R. 8 E. W.  
4 1/2 miles (distance) SE (direction) of Ocean Springs (nearest town)

WELL PURPOSE: home  
(home, irrigation, municipal, industrial)


- WELL COMPLETION DATA:
- (1) diameter (inches) 2"
  - (2) total depth (feet) 556'
  - (3) static water level (feet) 21 below top of ground.
  - (4) casing galv. (material), 546' (depth)  
2" (size) if telescope see back.
  - (5) screen 10' (length), 546' (depth to top)  
2" (size), stainless hardware (material)
  - (6) pump 1 (HP), 15 (yield gpm)  
disc. (type power)
  - (7) electric log no (yes or no)  
(organization running log)
  - (8) how well bottom plugged backwash valve

# CODED

DRILLERS REMARKS:

If well telescopes please sketch and show depths.

GROUND LEVEL

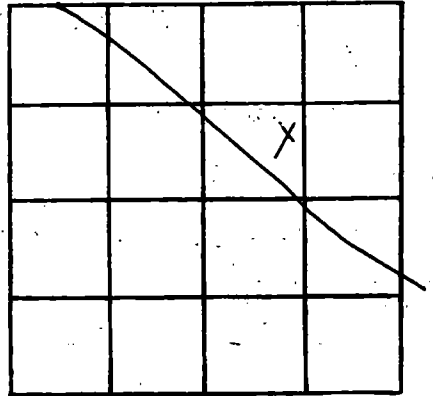

SECTION 10

Please indicate well location X.

ADDITIONAL INFORMATION

If more than one screen, show locations of each on sketch.