

JACKSON MISSISSIPPI BOARD OF WATER COMMISSIONERS

N 305

3-20-62

4507

WATER WELL DRILLERS LOG

CODED

Date: 3-20, 19 62, Driller: C. T. SWITZER WELL CO. County Jackson

(Name)

(1) Owner of Land: Thomas Hall

(Name)

Rt 1 Box 323 Ocean Springs

(Address)

(2) Location: 1/4, 1/4, Sec. 37 T. 7 R. 8

miles of (distance) (direction) (Nearest Town)

(3) Topography: (Hilly) (Flat) (Level)

(4) Purpose of Well: Domestic (Domestic Irrigation Municipal, Industrial, Other)

Description & Color of Materials Sand, Clay, Red Clay, Shell, etc.

Thick-ness Feet

Depth Feet

Clay	00	30
Sand, good	30	40
Sand, good	40	52
Clay	52	60
Sand, good	60	131
Clay	131	200
Sand	200	221

Information upon completion of well:

- (1) Diameter 2 inches.
- (2) Total Depth 221 feet.
- (3) Water Level 17' feet below top of ground.
- (4) Cased to 221', Size 2"
- (5) Screen: Size 2", Length 10'
- (6) Were any formations sealed against pollution?


yes, no.

If YES depth of formation

Why Health Dept. Requirements

Drillers Remarks:

CODED

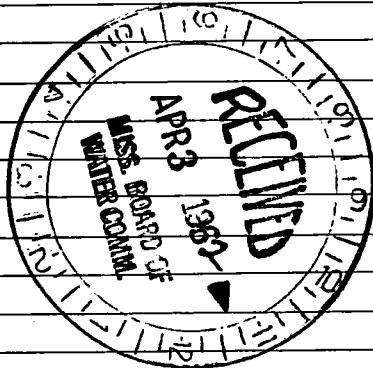

(Use Back Side)

Well No.

