

N307
4-13-62

WATER WELL DRILLERS LOG

CODED

Date: 4-13, 1962, Driller: C. I. SWITZER WELL CO. County: Jackson

(Name)

(1) Owner of Land: J. A. Harvey
(Name)
Ocean Springs, Miss.
(Address)

(2) Location: 1/4, 1/4, Sec. 14/23 T. 7 R. 8,
_____ miles _____ of _____
(distance) (direction) (Nearest Town)

(3) Topography: ↓
(Hilly) (Flat) (Level)

(4) Purpose of Well: Domestic
(Domestic Irrigation
Municipal, Industrial, Other)

Description & Color of Materials Sand, Clay, Red Clay, Shell, etc.	Thick- ness Feet	Depth Feet
<u>Clay</u>	<u>00</u>	<u>45</u>
<u>Sand, fine</u>	<u>45</u>	<u>71</u>
<u>Clay</u>	<u>71</u>	<u>180</u>
<u>Sand, fine</u>	<u>180</u>	<u>220</u>
<u>Clay</u>	<u>220</u>	<u>270</u>
<u>Sand, fine</u>	<u>270</u>	<u>280</u>
<u>Clay</u>	<u>280</u>	<u>400</u>
<u>Sand, fine</u>	<u>400</u>	<u>410</u>
<u>Sand, good</u>	<u>410</u>	<u>420</u>

Information upon completion of well:

(1) Diameter 2 inches.

(2) Total Depth 470 feet.

(3) Water Level 4' + feet below top of ground.

(4) Cased to 470', Size 2"


(5) Screen: Size 2", Length 10'

(6) Were any formations sealed against pollution?
✓ yes, _____ no.

CODED

If YES depth of formation _____
Why Health Dept. Requirement

Drillers Remarks: _____

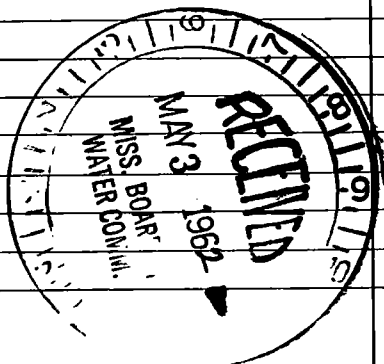

(Use Back Side)

Well No.

