

N 308

8-28-62

WATER WELL DRILLERS LOG

2743

CODED

Date: 8-19, 1962, Driller: C. T. SWITZER WELL CO. County: Jackson

(Name)

(1) Owner of Land: Ray Jette
(Name)
Coke Rd. Ocean Springs
(Address)

(2) Location: _____ 1/4, _____ 1/4, Sec. 1 T 7 R 9
_____ miles _____ of _____
(distance) (direction) (Nearest Town)

(3) Topography: _____
(Hilly) (Flat) (Level)

(4) Purpose of Well: Domestic
(Domestic Irrigation
Municipal, Industrial, Other)

| Description & Color of Materials Sand, Clay, Red Clay, Shell, etc. | Thick- ness Feet | Depth Feet |
|---|------------------------|---------------|
| Clay | 30 | 30 |
| Sand | 50 | 80 |
| Clay | 50 | 130 |
| Sand, good | 80 | 210 |
| Clay | 118 | 328 |
| Sand, fine | 190 | 518 |
| Clay | 199 | 717 |
| Sand, good | 232 | 949 |

Information upon completion of well:

(1) Diameter 2 inches.

(2) Total Depth 258 feet.

(3) Water Level 20' feet below top of ground.

(4) Cased to 258, Size 2"

(5) Screen: Size 2", Length 10'


(6) Were any formations sealed against pollution?
✓ yes, _____ no.

If YES depth of formation _____

Why Health Dept. Requirement

Drillers Remarks: _____

CODED

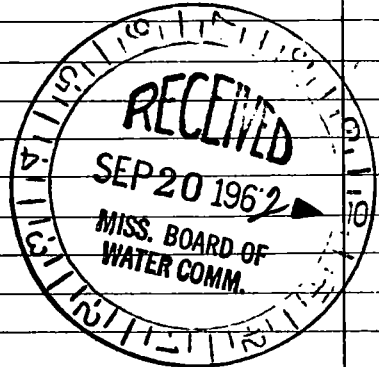

(Use Back Side)

Well No.

100
100
