

JACKSON

N310 1538

WATER WELL DRILLERS LOG

CODED

1-25-63

Date: 1-25-63, 1963, Driller: C. T. SWITZER WELL CO. County: Jackson

(Name)

(1) Owner of Land: John Bechtel (Name)

300 Park Estates, Ocean Springs (Address)

(2) Location: 1/4, 1/4, Sec. 29 T 7 R 8

miles of (distance) (direction) (Nearest Town)

(3) Topography: (Hilly) (Flat) (Level)

(4) Purpose of Well: Domestic Irrigation (Municipal, Industrial, Other)

Description & Color of Materials Sand, Clay, Red Clay, Shell, etc.	Thick- ness Feet	Depth Feet
Clay	00	11
Sand	11	22
Clay	23	39
Sand	39	50
Clay	50	64
Sand	64	110
Clay	110	140
Sand	140	154
Clay, fai	157	168
Sand	168	179
Clay	179	200
Clay w/sand etc	200	220
Clay	220	256
Clay w/sand etc	256	426
Clay w/sand etc	426	509
Sand w/clay, fai	509	521
Sand etc	521	527
Sand	527	557

Information upon completion of well:

(1) Diameter 2 inches.

(2) Total Depth 557 feet.

(3) Water Level 6' + feet below top of ground.

(4) Cased to 502', Size 2"

(5) Screen: Size 2", Length 10'

(6) Were any formations sealed against pollution?


yes, no.

If YES depth of formation

Why Health Dept. Requirements

Drillers Remarks:

CODED

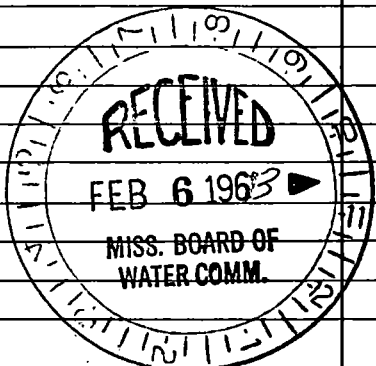

(Use Back Side)

Well No.

(138)

17

1848

1848

