

JACKSON

N314

3-27-63

WATER WELL DRILLERS LOG

4489

C. T. SWITZER WELL CO.

CODED

Date: 3-27-63, 1963, Driller: _____ County: Jackson

(Name)

(1) Owner of Land: Martin Hoff, Sr.
(Name)

48 Holcomb Blvd, Pearl Springs
(Address)

(2) Location: _____ 1/4, _____ 1/4, Sec. 29 T 7 R 8
 _____ miles _____ of _____
(distance) (direction) (Nearest Town)

(3) Topography: (Hilly) (Flat) (Level)

(4) Purpose of Well: Domestic
(Domestic Irrigation
 Municipal, Industrial, Other)

Description & Color of Materials Sand, Clay, Red Clay, Shell, etc.	Thick- ness Feet	Depth Feet
Clay	00	54
Sand	54	60
Sand, fine	60	68
Clay	68	70
Sand, good	70	135
Clay	135	140
Sand, good	140	160
Clay, fine sand etc	160	180
Clay	180	260
Sand, fine	260	275
Clay	275	300
Sand, good	300	340

Information upon completion of well:

(1) Diameter 2 inches.

(2) Total Depth 340 feet.

(3) Water Level 13' feet below top of ground.

(4) Cased to 340', Size 2"

(5) Screen: Size 2", Length 10'


(6) Were any formations sealed against pollution?
 yes, _____ no.

CODED


If YES depth of formation _____

Why Health Dept. Requirements

Drillers Remarks: _____

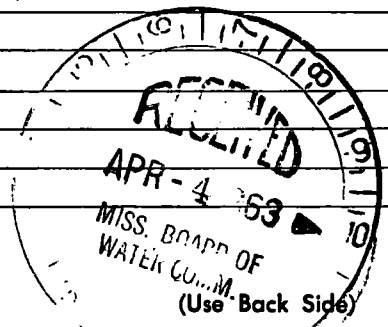

Well No.

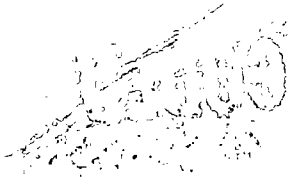

1857

The following is a list of the
 names of the persons who
 have been admitted to
 the office of the
 Secretary of the
 Board of Education
 since the last meeting
 of the Board on the
 1st day of January
 1857.

No.	Name	Office	Term
1
2
3
50