

JACKSON

N 315

4-4-63

MISSISSIPPI BOARD OF WATER COMMISSIONERS

WATER WELL DRILLERS LOG

CODED

Date: 4-4, 1963, Driller: C. T. SWITZER WELL CO. County: Jackson

(Name)

(1) Owner of Land: Ray Hutton

(Name)

123 Malcolm Road, New Spring

(Address)

(2) Location: 1/4, 1/4, Sec. 23 T. 7 R. 8

 miles of
(distance) (direction) (Nearest Town)

(3) Topography:

(Hilly)

(Flat)

(Level)

(4) Purpose of Well: Domestic(Domestic Irrigation
Municipal, Industrial, Other)

Information upon completion of well:


(1) Diameter 2" inches.(2) Total Depth 480 feet.(3) Water Level 9' feet below top of ground.(4) Cased to 480', Size 2"(5) Screen: Size 2", Length 10'

(6) Were any formations sealed against pollution?

✓ yes, no.If YES depth of formation Why North Dept. requirementDrillers Remarks: Description & Color of Materials
Sand, Clay, Red Clay, Shell, etc.Thick-
ness
FeetDepth
Feet

Clay	00	05
Sand	05	10
Clay	10	40
Sand, good	40	60
Clay	60	80
Sand, fine	80	92
Clay	92	100
Sand, good	100	110
Clay	110	240
Sand, not fine	240	280
Clay	280	380
Sand, fine	380	390
Sand Sand	410	420
Sand, fair	420	440
Sand, good	440	480
Clay	480	410

CODED

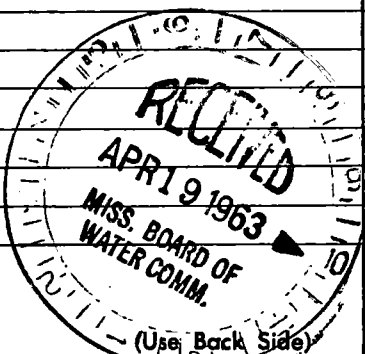

Well No.

Mail this copy to Board of Water Commissioners 429 Miss. St. Jackson, Miss.

