

JACKSON
N316

WATER WELL DRILLERS LOG

CODED

4-5-63

3978

C. T. SWITZER WELL CO.

Date: 4-5, 1963, Driller:

County: Jackson

(Name)

(1) Owner of Land: Arthur Hall
(Name)

(Address)

(2) Location: 1/4, 1/4, Sec. 17 T 8 R

miles of (distance) (direction) (Nearest Town)

(3) Topography: (Hilly) (Flat) (Level)

(4) Purpose of Well: Domestic
(Domestic Irrigation, Municipal, Industrial, Other)

Description & Color of Materials Sand, Clay, Red Clay, Shell, etc.	Thick- ness Feet	Depth Feet
Clay	10	10
Sand	10	20
Clay w/ few sand str.	20	40
Sand, good	40	80
Clay	40	120
Sand, fair	120	160
Sand, not good	160	184

Information upon completion of well:

(1) Diameter 2 inches.

(2) Total Depth 184 feet.

(3) Water Level 12 feet below top of ground.

(4) Cased to 184', Size 2"

(5) Screen: Size 2", Length 10'


(6) Were any formations sealed against pollution?
yes, no.

If YES depth of formation

Why: Health Dept. Requirement

Drillers Remarks:

CODED

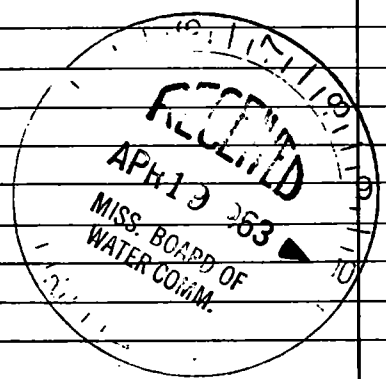

(Use Back Side)

Well No.

Handwritten notes and scribbles at the top of the page, including the number "11" on the right side.

Main body of handwritten text, appearing as a list or series of notes, with some faint lines and markings.

Bottom section of the page containing a grid-like structure on the left and additional handwritten text on the right.