

N 318

5-8-63

WATER WELL DRILLERS LOG

CODED

Date: May 8, 1963, Driller: L. L. Garland County Jackson
(Name)

(1) Owner of Land:	Description & Color of Materials Sand, Clay, Red Clay, Shell, etc.	Thick- ness Feet	Depth Feet
<u>Arthur Hamey</u> <small>(Name)</small> <u>Big Ridge</u> <small>(Address)</small>	1 10' M. 11' Sand		
(2) Location: $\frac{1}{4}$, $\frac{1}{4}$, Sec. <u>12 T7 R9</u> <u>3</u> miles <u>NW</u> of <u>O.S.</u> <small>(distance) (direction) (Nearest Town)</small>	2 M. & S.S.		
(3) Topography: <u>Dom.</u> <small>(Hilly) (Flat) (Level)</small>	3 Mix.		
(4) Purpose of Well: <u>Dom.</u> <small>(Domestic Irrigation Municipal, Industrial, Other)</small>	4 "		
	5 "		
	6 "		
	7 "		
	8 Sand		
	9 M. & S.S.		
	10 Mix.		
	11 Mud		
	12 "		
	13 Mix.		
	14 Mud		
	15 " & S.S.		
	16 "		
	17 " "		
	18 Shale		
	19 "		
	20 M. & S.S.		
	21 14' M. 7' S.		
	22 10' Sand		

Information upon completion of well:

(1) Diameter 2 inches.

(2) Total Depth 451 feet.

(3) Water Level 23 feet below top of ground.

(4) Cased to _____, Size _____

(5) Screen: Size .0, Length 10


(6) Were any formations sealed against pollution?
 _____ yes, _____ no.

If YES depth of formation _____

Why _____

Drillers Remarks: _____

CODED

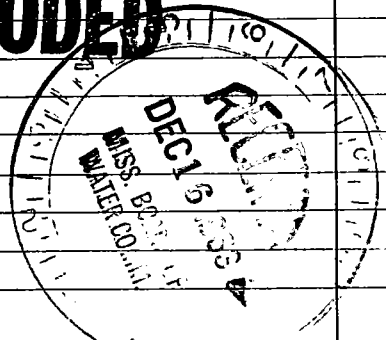

(Use Back Side)

Well No.

