

JACKSON MISSISSIPPI BOARD OF WATER COMMISSIONERS

N319 2185
7-3-63

WATER WELL DRILLERS LOG

CODED

Date: July 3, 1963, Driller: Arthur King Britton County: Sumner
(Name)

(1) Owner of Land:	Description & Color of Materials Sand, Clay, Red Clay, Shell, etc.	Thick- ness Feet	Depth Feet
<u>J. E. Brune</u> (Name)	<u>Blue Clay</u>	0-	15
<u>Rasm Springs</u> (Address)	<u>White Clay</u>	15-	45
(2) Location: <u>1/4</u> , <u>1/4</u> , Sec. <u>18 T2 R8</u>	<u>White Sand</u>	45-	55
_____ miles _____ of _____ (distance) (direction) (Nearest Town)	<u>Blue Clay</u>	55-	80
(3) Topography: _____ (Hilly) (Flat) (Level)	<u>Blue Sand</u>	80-	140
(4) Purpose of Well: <u>Domestic</u> (Domestic Irrigation Municipal, Industrial, Other)	<u>Blue Clay</u>	140-	230
	<u>Blue Sand</u>	230-	235
	<u>Blue Clay</u>	235-	246
	<u>Blue Sand</u>	246-	272

Information upon completion of well:


- (1) Diameter 2" inches.
- (2) Total Depth 272 feet.
- (3) Water Level 12 feet below top of ground.
- (4) Cased to _____, Size _____
- (5) Screen: Size 2", Length 1'
- (6) Were any formations sealed against pollution?
_____ yes, X no.

If YES depth of formation _____

Why _____

Drillers Remarks: _____

CODED

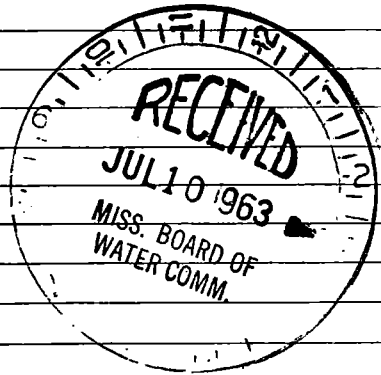

(Use Back Side)

Well No.

