

N320¹⁸⁵⁸

WATER WELL DRILLERS LOG

CODED

7-26-63

C. T. SWITZER WELL CO.

Date: 7/26, 1963, Driller: _____ County: Harrison

(Name)

(1) Owner of Land: John Bourgeois
(Name)
North Ave, New Spring
(Address)
(2) Location: _____ ¼, _____ ¼, Sec. 7 T. 2 R. 8
_____ miles _____ of _____
(distance) (direction) (Nearest Town)
(3) Topography: (Hilly) (Flat) (Level)
(4) Purpose of Well: Domestic
(Domestic Irrigation
Municipal, Industrial, Other)


Description & Color of Materials Sand, Clay, Red Clay, Shell, etc.	Thick- ness Feet	Depth Feet.
<u>Clay</u>	<u>80</u>	<u>110</u>
<u>sand, good</u>	<u>40</u>	<u>100</u>
<u>Clay of hard str</u>	<u>100</u>	<u>120</u>
<u>sand, good</u>	<u>120</u>	<u>156</u>

Information upon completion of well:

(1) Diameter 2 inches.
(2) Total Depth 150 feet.
(3) Water Level 13' feet below top of ground.
(4) Cased to 150', Size 2"
(5) Screen: Size 2", Length 10'
(6) Were any formations sealed against pollution?
 yes, _____ no.

If YES depth of formation _____
Why Health Dept. requirement
Drillers Remarks: _____

CODED

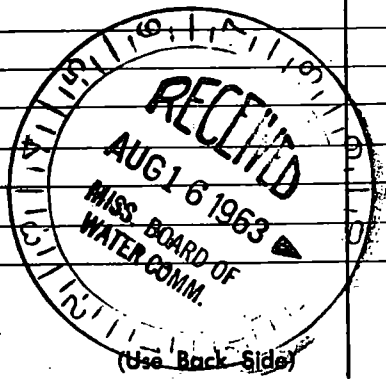

Well No.

