

JACKSON

CODED

N323  
9-8-63

WATER WELL DRILLERS LOG

Date: 9-8, 1963, Driller: C. T. SWITZER WELL CO. County: Jackson

(Name)

(1) Owner of Land: W.K. Hunk

(Name)

Suburbanville Place

(Address)

(2) Location: 1/4, 1/4, Sec. 16 T7R9

miles of (distance) (direction) (Nearest Town)

(3) Topography:

(Hilly) (Flat) (Level)

(4) Purpose of Well: Domestic

(Domestic Irrigation  
Municipal, Industrial, Other)

Description & Color of Materials  
Sand, Clay, Red Clay, Shell, etc.

Thick-  
ness  
Feet

20-35 sand  
35-42 clay  
42-65 sand  
65-104 clay  
104-126 sand  
126-240 clay  
240-331 sand

Information upon completion of well:

(1) Diameter 7 inches.

(2) Total Depth 331 feet.

(3) Water Level 3' + feet below top of ground.

(4) Cased to 331', Size 2"

(5) Screen: Size 2", Length 15'

(6) Were any formations sealed against pollution?


yes, no.

If YES depth of formation

Why Health Dept. requirements

Drillers Remarks:

CODED

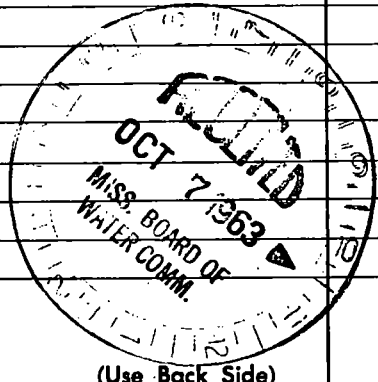

(Use Back Side)

Well No.

Ed

Wm. H. ...  
...

...

...

...