

JACKSON

N 325

1-19-64

WATER WELL DRILLERS LOG

4488

CODED

Date: 1-19, 1964, Driller: C.T. Switzer County: Wilcox

(Name)

(1) Owner of Land: Dr. Arthur Smith (Name)  
C. Beach, Ocean Springs (Address)

(2) Location: 1/4, 1/4, Sec. 29 T 7 R 8  
miles of (distance) (direction) (Nearest Town)

(3) Topography: (Hilly) (Flat) (Level)

(4) Purpose of Well: Domestic (Domestic Irrigation Municipal, Industrial, Other)

Description & Color of Materials Sand, Clay, Red Clay, Shell, etc.	Thick- ness Feet	Depth Feet
Sand	10	14
Clay	14	48
Sand	10	54
Clay	34	66
Sand	66	80
Sand, gravel	80	105

Information upon completion of well:

(1) Diameter 2 inches.

(2) Total Depth 105' feet.

(3) Water Level 12' - 18' feet below top of ground.

(4) Cased to 105', Size 2"

(5) Screen: Size 2", Length 10'


(6) Were any formations sealed against pollution?  
Yes, no.

If YES depth of formation

Why: Health Dept. requirements

Drillers Remarks:

CODED

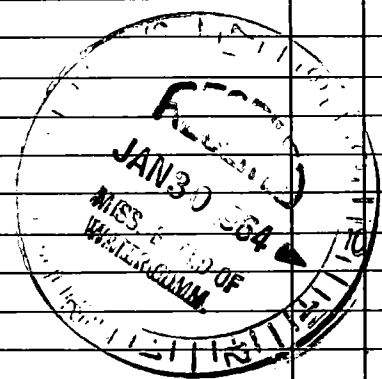

Well No.

(Use Back Side)

