

N 326  
1-28-64

WATER WELL DRILLERS LOG

**CODED**

Date: 1-28, 1964, Driller: C. I. SWITZER WELL CO. County: Jackson  
(Name)

(1) Owner of Land: Switzer Matthew  
(Name)  
on North St. in Oak Leaf Sub. near drainage  
(Address)

(2) Location: 1/4, 1/4, Sec. 23 T2 R8,  
\_\_\_\_\_ miles \_\_\_\_\_ of \_\_\_\_\_  
(distance) (direction) (Nearest Town)

(3) Topography: \_\_\_\_\_  
(Hilly) (Flat) (Level)

(4) Purpose of Well: Domestic  
(Domestic Irrigation  
Municipal, Industrial, Other)

Description & Color of Materials Sand, Clay, Red Clay, Shell, etc.	Thick- ness Feet	Depth Feet
SAND	05	05
clay	05	20
sandy clay siks	20	40
SAND	10	50
clay	30	80
SAND	80	120
clay	120	200
sandy clay siks	200	220
sand, good	220	270

Information upon completion of well:

(1) Diameter 2 inches.

(2) Total Depth 270 feet.

(3) Water Level 12' feet below top of ground.

(4) Cased to 270', Size 2"


(5) Screen: Size 2", Length 10'

(6) Were any formations sealed against pollution?  
 yes, \_\_\_\_\_ no.

**CODED**

If YES depth of formation \_\_\_\_\_  
Why Health Dept requirement

Drillers Remarks: \_\_\_\_\_

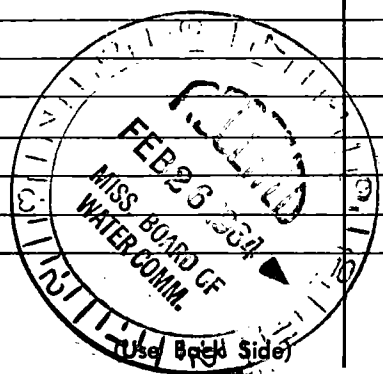

Well No. \_\_\_\_\_

03003