

N 328
5-4-64

WATER WELL DRILLERS LOG

CODED

Date: 5-4, 1964, Driller: G. I. SWITZER WELL CO. County: Jackson

(Name)

(1) Owner of Land: John Westmoreland
(Name)
Coak Rd N Ocean Springs
(Address)

(2) Location: 1/4, 1/4, Sec. 13 T 7 R 9,
_____ miles _____ of _____
(distance) (direction) (Nearest Town)

(3) Topography: (Hilly) (Flat) (Level)

(4) Purpose of Well: Domestic
(Domestic Irrigation
Municipal, Industrial, Other)

Description & Color of Materials Sand, Clay, Red Clay, Shell, etc.	Thick- ness Feet	Depth Feet
clay w/ few sand etc	10	20
clay	20	38
clay	38	48
clay	18	238
sand	238	210
sand, fine	210	255
clay	255	320
sand, good	320	332
clay	332	375
clay	375	380
sand, fine	380	400
sand, good	400	440

Information upon completion of well:

(1) Diameter _____ inches.

(2) Total Depth 440' feet.

(3) Water Level 14' 5" feet below top of ground.

(4) Cased to 440', Size 2x3"

(5) Screen: Size 2", Length 15'


(6) Were any formations sealed against pollution?
 yes, _____ no.

CODED

If YES depth of formation _____

Why Health Dept. requirements

Drillers Remarks: _____

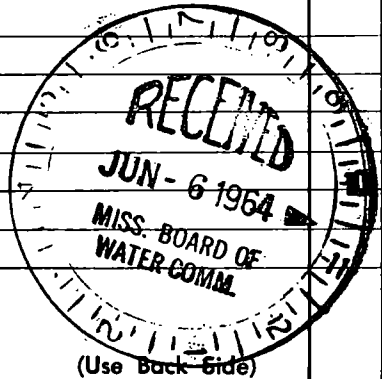

Well No.

