

**JACKSON MISSISSIPPI BOARD OF WATER COMMISSIONERS**


N 329  
5-13-64

168 179

**WATER WELL DRILLERS LOG**

Date: May 13, 19 64, Driller: Jarrington B. ...

(Name)

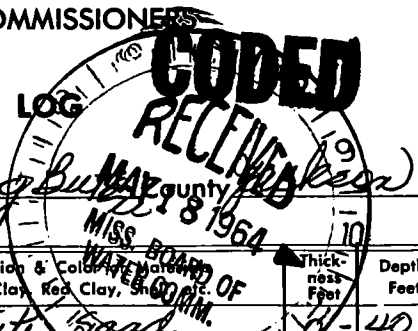

(1) Owner of Land: W P Rhoton  
Real Estate  
Biloxi Miss

(2) Location: near Fountainbleau  
5 miles N. E. of Spring

(3) Topography: X  
(Hilly) (Flat) (Level)

(4) Purpose of Well: domestic  
(Domestic Irrigation, Municipal, Industrial, Other)

Description & Color	Thickness Feet	Depth Feet
Sand, Clay, Red Clay, Shale		
<u>white sand</u>	<u>40</u>	<u>40</u>
<u>Blue clay</u>	<u>40</u>	<u>175</u>
<u>Blue sand</u>	<u>175</u>	<u>215</u>

**Information upon completion of well:**

(1) Diameter 2 inches.

(2) Total Depth 215 feet.

(3) Water Level 1 feet below top of ground.

(4) Cased to \_\_\_\_\_, Size \_\_\_\_\_

(5) Screen: Size 2", Length 10'

(6) Were any formations sealed against pollution?  
0 yes, X no.

If YES depth of formation \_\_\_\_\_

Why \_\_\_\_\_

Drillers Remarks: \_\_\_\_\_

**CODED**

(Use Back Side)

Well No.



THE UNIVERSITY OF CHICAGO  
LIBRARY

