

N 337

WATER WELL DRILLERS LOG

CODED

4-28-66

4067

Date: 4-28, 1966, Driller: H.O. Riddell County Jackson  
Coast Water Well Dr.

(1) Owner of Land: Rudolph Rees  
(Name)

Biloxi, Miss  
(Address) 379

(2) Location: 1/4, 1/4, Sec. N T 7 R 7  
8 miles North of Biloxi  
(distance) (direction) (Nearest Town)

(3) Topography:  (Level)  
(Hilly) (Flat)

(4) Purpose of Well: Home  
(Domestic Irrigation  
Municipal, Industrial, Other)

Description & Color of Materials Sand, Clay, Red Clay, Shell, etc.	Thick- ness Feet	Depth Feet
Red Clay	21	21
Thin sand	10	31
Blue Clay	11	42
" "	21	63
Sandy shale	21	84
Shaly sand & shale	42	126
Blue Clay	21	147
" "	21	168
" "	21	189
" "	21	210
Blue Clay & shale	21	231
" "	21	252
" "	21	273
" "	21	294
" "	21	315
" "	21	336
" "	21	357
" "	21	378
Thin Turbidity sand	11	389

Information upon completion of well:

(1) Diameter 2" inches.

(2) Total Depth 389 feet.

(3) Water Level 15 feet below top of ground.

(4) Cased to \_\_\_\_\_, Size \_\_\_\_\_

(5) Screen: Size 2", Length 5'

(6) Were any formations sealed against pollution?  
\_\_\_\_\_ yes,  no.

If YES depth of formation \_\_\_\_\_


Why \_\_\_\_\_

Drillers Remarks: \_\_\_\_\_

\_\_\_\_\_

\_\_\_\_\_

CODED

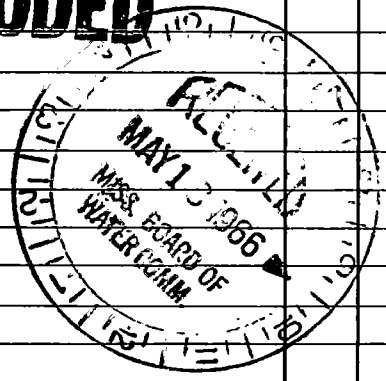

(Use Back Side)

Well No.

