

N 338

5-17-66

WATER WELL DRILLERS LOG

4123

CODED

Date: 5-17, 1966, Driller: C.T. Switzer Well Co. County Jackson  
(Name)

(1) Owner of Land: A. A. Smith  
(Name)

P.O. Box 641, Ocean Springs  
(Address)

(2) Location: 1/4, 1/4, Sec. 16 T. 7 R. 9  
\_\_\_\_\_ miles \_\_\_\_\_ of \_\_\_\_\_  
(distance) (direction) (Nearest Town)

(3) Topography: X  
(Hilly) (Flat) (Level)

(4) Purpose of Well: domestic  
(Domestic Irrigation  
Municipal, Industrial, Other)

Description & Color of Materials Sand, Clay, Red Clay, Shell, etc.	Thick- ness Feet	Depth Feet
sand	0	18
soft clay	18	22
clay	22	61
fine sand	61	66
mixed	66	88
fine sand	88	97
soft clay	97	107
sand	107	110
sand	110	127
clay	127	136
sand	136	156
clay	156	160
sand	160	189
clay	189	239
rock	239	239 1/2
clay	239 1/2	284 1/2
mixed	284 1/2	302 1/2
clay	302 1/2	324 1/2
mixed	324 1/2	346 1/2
sand	346 1/2	352 1/2
mixed	352 1/2	366 1/2
sand	366 1/2	368 1/2
sand	368 1/2	370 1/2
Clay	370 1/2	372 1/2
sand	372 1/2	378 1/2
clay	378 1/2	394 1/2
sand	394 1/2	406 1/2
clay	406 1/2	431 1/2
stratified	431 1/2	454 1/2
Fullers Earth	454 1/2	472 1/2
sand	472 1/2	496 1/2
sand	496 1/2	517 1/2

Information upon completion of well:

(1) Diameter 2 1/2 inches.

(2) Total Depth 517 feet.

(3) Water Level 10' feet below top of ground.

(4) Cased to 517', Size 2" x 2 1/2"


(5) Screen: Size 10 ga ss, Length 10'

(6) Were any formations sealed against pollution?  
X yes, \_\_\_\_\_ no.

If YES depth of formation \_\_\_\_\_

Why Health Dept. Regmental

Drillers Remarks: \_\_\_\_\_

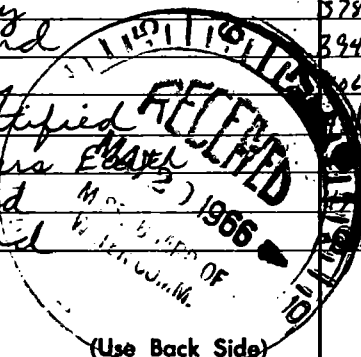

Well No

