

JACKSON
N 345
4-23-71

MISSISSIPPI
 BOARD OF WATER COMMISSIONERS
 416 North State Street
 Jackson, Mississippi 39201

CODED

WATER WELL DRILLERS LOG

4-23-71 19 R. J. Moore JACKSON
 date well completed firm name county well located

LANDOWNER: JACK TIBILETT
TIBILETT Drake Concrete Co
North Biloxi MISS
 (mailing address)

description of formations encountered	from	to
<u>TOP SOIL</u>	<u>0</u>	<u>20</u>
<u>Surface Sand</u>	<u>20</u>	<u>30</u>
<u>Gravel mud</u>	<u>30</u>	<u>41</u>
<u>Blue clay</u>	<u>41</u>	<u>258</u>
<u>Gravel sand</u>	<u>258</u>	<u>260</u>

WELL LOCATION:
 sec. 10 T. 7 N R. 9 E
2 blocks S of Saint Martin School
 (distance) (direction) (nearest town)
North Biloxi

WELL PURPOSE:
 (home irrigation, municipal, industrial)

WELL COMPLETION DATA:

- (1) diameter (inches) 2"
- (2) total depth (feet) 260'
- (3) static water level (feet) 32' ^{below} above top of ground.
- (4) casing SAW 250'
 (material) (depth)
- _____ If telescope see back.
 (size)
- (5) screen 2 X 10 250'
 (length) (depth to top)
- 2" SS
 (size) (material)
- (6) pump _____
 (HP) (yield gpm)
- _____ (type power)
- (7) electric log _____
 (yes or no)
- _____ (organization running log)
- (8) how well bottom plugged Yes
W. H. H.

CODED


MAY 2 1971

DRILLERS REMARKS:

MISS. EXP. WATER

If well telescopes please sketch and show depths.

GROUND LEVEL

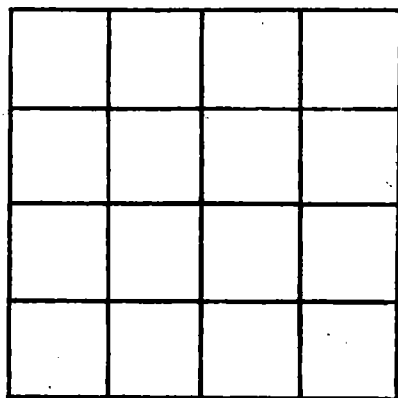

SECTION _____

Please indicate well location X.

ADDITIONAL INFORMATION

If more than one screen, show locations of each on sketch.