

JACKSON

N 348

4-20-71

MISSISSIPPI
 BOARD OF WATER COMMISSIONERS
 416 North State Street
 Jackson, Mississippi 39201

CODED

WATER WELL DRILLERS LOG

April 20 1971
date well completed

L.D. Garland Water Wells Jackson
firm name county well located

LANDOWNER: C.W. Hodson

Rt. 6 Box 392 A

Hattiesburg, Miss
(mailing address)

description of formations encountered

from to

WELL LOCATION:

sec. 1 T. 8 N R. 8 E
③ (W)
5 miles East of D.S.
(distance) (direction) (nearest town)

WELL PURPOSE: home
(home, irrigation, municipal, industrial)

WELL COMPLETION DATA:

- (1) diameter (inches) 2
- (2) total depth (feet) 346
- (3) static water level (feet) 21 ^{below} _{above} top of ground.
- (4) casing steel, 336
(material) (depth)

CODED

_____ if telescope see back.
(size)

- (5) screen 10ft, 336
(length) (depth to top)

2", steel
(size) (material)

- (6) pump 1/2 500 gal per hr
(HP) (yield/gpm)

electric
(type power)

- (7) electric log _____
(yes or no)

MAY 5 - 1971

_____ (organization running log)

MISS. BD. OF
WATER COMMISSIONERS


- (8) how well bottom plugged back w. valve.

DRILLERS REMARKS:

32 ft. water bearing sand

If well telescopes please sketch and show depths.

GROUND LEVEL

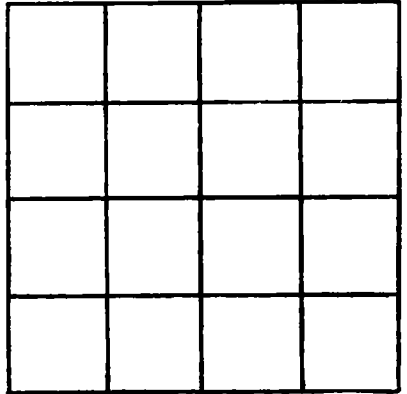

SECTION _____

Please indicate well location X.

ADDITIONAL INFORMATION

If more than one screen, show locations of each on sketch.