

MISSISSIPPI  
BOARD OF WATER COMMISSIONERS  
416 North State Street  
Jackson, Mississippi 39201

**CODED**

WATER WELL DRILLERS LOG

JACKSON  
N349  
5-2-71

5/2/71  
date well completed

Postal Drilling Co. Jackson  
firm name county well located

LANDOWNER: Eric Clay  
24 Ruth St.  
Olson Spring, Miss  
(mailing address)

description of formations encountered	from	to
top soil	1	3
white sand	3	18
red sand	18	35
blue clay	35	208
fine water sand	208	220
hard clay	220	260
fine water sand	260	280
coarse water sand	280	308

WELL LOCATION:  
sec 12 T 2N R 9E  
S W  
1 miles NW of Huff Hill  
(distance) (direction) (nearest town)

WELL PURPOSE:  
(home, irrigation, municipal, industrial)

WELL COMPLETION DATA:

(1) diameter (inches) 2"

(2) total depth (feet) 308

(3) static water level (feet) 20 <sup>below</sup> <sub>above</sub> top of ground. below

(4) casing gal, 298  
(material) (depth)

(size) If telescope see back.

(5) screen 10', 298  
(length) (depth to top)

2", 35  
(size) (material)

(6) pump 1/2, 17  
(HP) (yield gpm)

ch  
(type power)

(7) electric log no  
(yes or no)

(organization running log)

**CODED**

(8) how well bottom plugged  
2" sand with water


MAY 18 1971

DRILLERS REMARKS:  
None

MISS. BD. OF  
WATER COMMISSIONERS

If well telescopes please sketch and show depths.

GROUND LEVEL

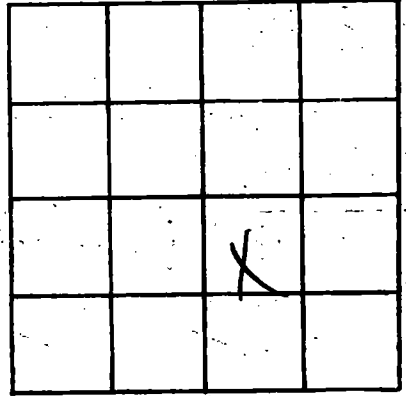

SECTION \_\_\_\_\_

Please indicate well location X.

ADDITIONAL INFORMATION

If more than one screen, show locations of each on sketch.