

JACKSON
N 351
5-24-71

MISSISSIPPI
BOARD OF WATER COMMISSIONERS
416 North State Street
Jackson, Mississippi 39201

CODED

WATER WELL DRILLERS LOG

May 24 1971 L.L. Garland Water Wells Jackson
date well completed firm name county well located

LANDOWNER: Sandra Capera
701st Bayou Rd.
Olean Springs, Miss.
(mailing address)

description of formations encountered from to

WELL LOCATION:
sec. 18 T 7 N R 8 E
2 miles north of O.S.
(distance) (direction) (nearest town)

WELL PURPOSE: home
(home, irrigation, municipal, industrial)

- WELL COMPLETION DATA:
- (1) diameter (inches) 2
 - (2) total depth (feet) 451
 - (3) static water level (feet) 36 ^{below} above top of ground.
 - (4) casing steel, 441, (material), (depth), (size) if telescope see back.
 - (5) screen 10 ft, 441 (length), (depth to top), 2", s. steel (size), (material)
 - (6) pump 1/2 400 gal. per hr (HP), (yield gpm), electric (type power)
 - (7) electric log (yes or no)
 - (organization running log)

CODED

JUN 10 1971


(8) how well bottom plugged
flush wash valve

DRILLERS REMARKS:
22 ft. water bearing
bearing sand

MISS. INT. OF
WATER CO.

If well telescopes please sketch and show depths.

GROUND LEVEL

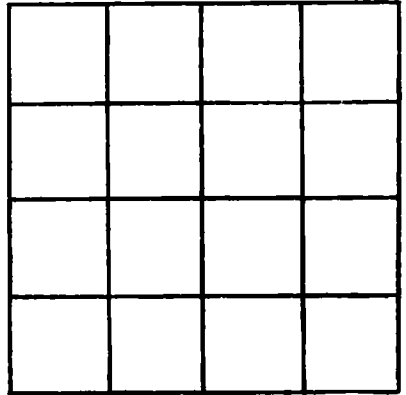

SECTION _____

Please indicate well location X.

ADDITIONAL INFORMATION

Lined area for additional information, consisting of 20 horizontal lines.

If more than one screen, show locations of each on sketch.