

coded

ELOG# 172

JACKSON
N355
11-10-71

MISSISSIPPI
BOARD OF WATER COMMISSIONERS
416 North State Street
Jackson, Mississippi 39201

DEC 20 1971

WATER WELL DRILLERS LOG **CODED**

11-19 1971 Switzer Well Company JACKSON
date well completed firm name county well located

LANDOWNER: Cedar Grove Subd.
Hwy 90 Coast Waterworks
Biloxi, Miss.
(mailing address)

WELL LOCATION:
sec. 10 T. 7 S. R. 9 W.
2 miles NE of Biloxi
(distance) (direction) (nearest town)

WELL PURPOSE:
(home, irrigation, municipal, industrial)

WELL COMPLETION DATA:
(1) diameter (inches) 8"
(2) total depth (feet) 792'
(3) static water level (feet) 27 below
top of ground. above
(4) casing black pipe 792'
(material) (depth)
12" if telescope see back.
(size)
(5) screen 60 732'
(length) (depth to top)
008 stainless steel
(size) (material)
(6) pump 30 350
(HP) (yield gpm)
Electric
(type power)
(7) electric log YES
(yes or no)
MGS
(organization running log)
(8) how well bottom plugged Metal
4' backwash valve.

description of formations encountered	from	to
Gravel	0	1
Clay	1	7
SAND	7	17
CLAY	17	21
SAND	21	36
MIXED	36	41
SAND	41	58
CLAY	58	84
MIXED	84	101
CLAY	101	105
SAND	105	115
CLAY	115	124
SAND	124	139
CLAY	139	161
MIXED	161	181
CLAY	181	231
SAND	231	247
CLAY	247	323
SAND	323	327
CLAY	327	338
CLAY + Shell	338	378
CLAY	378	398
CLAY + SHAIL	398	408
ROCK PATCH	408	409
CLAY	409	477
CLAY + SHAIL	477	496
CLAY	496	516
SAND	516	524
CLAY	524	561
SAND	561	576
SAND, good	576	632
CLAY	632	664
ROCK	664	670
CLAY	670	725
SAND	725	738
MIXED	738	745
SAND	745	792
CLAY	792	794
CLAY + shail	794	814
CLAY	814	828
SAND	828	834



CODED

DRILLERS REMARKS:

(over)

If well telescopes please sketch and show depths.

GROUND LEVEL

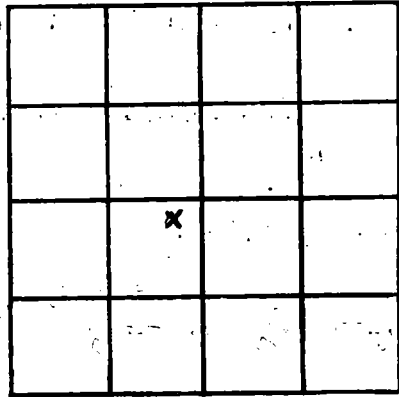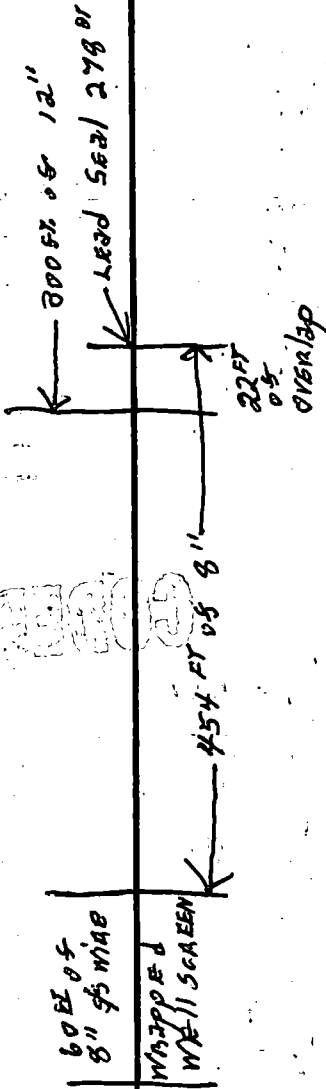

SECTION 10

Please indicate well location X.

ADDITIONAL INFORMATION

sand, fine	834 - 865
sand, good	865 - 873
clay	873 - 895

Well set at 792.

If more than one screen, show locations of each on sketch.