

JACKSON

MISSISSIPPI BOARD OF WATER COMMISSIONERS
416 North State Street
Jackson, Mississippi 39201

WATER WELL DRILLERS LOG

JACKSON

~~HARRISON~~
N 358
10-19-71

Oct 19, 71
date well completed

19 Coastal Drilling Co.
firm name

Harrison
county well located

LANDOWNER:

John Trants

description of formations encountered

from to

Rt 2 Hwy Rd
Belopi, Miss
(mailing address)

Top Soil 1 3
Blue Clay 3 15
White Sand 15 28
Red Sand 28 40
Blue Clay 40 280
fine Water Sand 280 300
fine Water Sand 300 315

WELL LOCATION:

sec. 3 T 7 N R 9 E
S W
(2) Two miles N of Belopi
(distance) (direction) (nearest town)

WELL PURPOSE:

home
(home, irrigation, municipal, industrial)

WELL COMPLETION DATA:

- (1) diameter (inches) 2"
- (2) total depth (feet) 315
- (3) static water level (feet) 35 below top of ground
- (4) casing glass 305 (material) (depth)
- (size) If telescope see back.
- (5) screen 10' 305 (length) (depth to top)
- 2" 55 (size) (material)
- (6) pump One 16 (HP) (yield gpm)
- Ele (type power)
- (7) electric log No (yes or no)

(organization running log)

(8) how well bottom plugged
2" mechanical valve

DRILLERS REMARKS:


none

JAN 10 1972

MISS. Bd. of WATER COMMISSIONERS

If well telescopes please sketch and show depths.

GROUND LEVEL

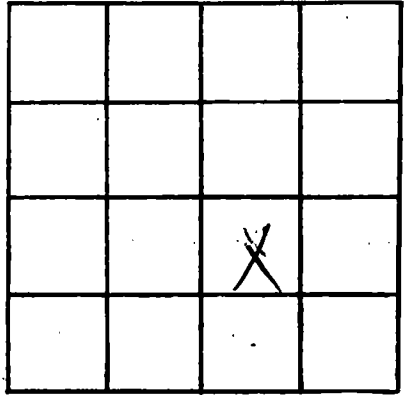

SECTION _____

Please indicate well location X.

ADDITIONAL INFORMATION

If more than one screen, show locations of each on sketch.