

JACKSON  
N 360  
1-6-72

MISSISSIPPI  
BOARD OF WATER COMMISSIONERS  
416 North State Street  
Jackson, Mississippi 39201

CODED

WATER WELL DRILLERS LOG

Jan 6 1972 M & B Drilling Co. Jackson  
date well completed firm name county well located

LANDOWNER: Elmer Ladnier

description of formations encountered

from to

Rt. 4 Box 395

Ocean Springs, Miss.  
(mailing address)

WELL LOCATION:

sec 23 T 7 S R 8 W  
2 miles E of Ocean Springs  
(distance) (direction) (nearest town)

WELL PURPOSE: Home  
(home, irrigation, municipal, industrial)

WELL COMPLETION DATA:

- (1) diameter (inches) 2
- (2) total depth (feet) 924
- (3) static water level (feet) 6 below  
top of ground.
- (4) casing Col. Steel 914  
(material) (depth)  
2"  
(size) if telescope see back.
- (5) screen 10 FT 914  
(length) (depth to top)  
2" Stainless Steel .008  
(size) (material)
- (6) pump 1/2 8  
(HP) (yield gpm)  
110 Volt 1 $\phi$   
(type power)
- (7) electric log No  
(yes or no)

(organization running log)

- (8) how well bottom plugged  
2" Pack Wash Check

DRILLERS REMARKS:

description of formations encountered	from	to
<u>Top soil &amp; Sand</u>	<u>0</u>	<u>5</u>
<u>Gray Clay</u>	<u>5</u>	<u>20</u>
<u>Gravel &amp; Sand Break</u>	<u>20</u>	<u>70</u>
<u>Red Sand &amp; Clay Breaker</u>	<u>70</u>	<u>255</u>
<u>Gray Clay</u>	<u>255</u>	<u>300</u>
<u>Sand &amp; Clay Breaker</u>	<u>300</u>	<u>470</u>
<u>White Sand &amp; Wood</u>	<u>470</u>	<u>505</u>
<u>Blue Clay</u>	<u>505</u>	<u>885</u>
<u>Sand</u>	<u>885</u>	<u>924</u>
<u>Blue Clay &amp; Shell</u>	<u>924</u>	<u>972</u>


CODED

JAN 26 1972

MISS. BD. OF  
WATER COMMISSIONERS

If well telescopes please sketch and show depths.

GROUND LEVEL

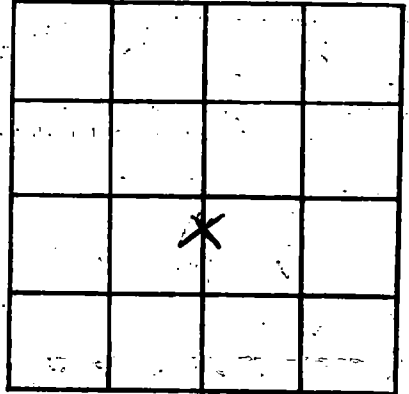

SECTION 23

Please indicate well location X.

ADDITIONAL INFORMATION

If more than one screen, show locations of each on sketch.