

# CODED

MISSISSIPPI  
BOARD OF WATER COMMISSIONERS  
416 North State Street  
Jackson, Mississippi 39201

FEB 17 1972

WATER WELL DRILLERS LOG

MISS. BD. OF  
WATER COMM.

JACKSON  
N 362  
1-6-72

1-6 1972  
date well completed

Switzer Well Co.  
firm name


JACKSON  
county well located

LANDOWNER: <u>bevard forehand</u>	description of fomations encountered	from	to
<u>Rt. 3 Box 274-D</u>			
<u>Ocean Springs, Miss.</u>	<u>sand - clay mixed</u>	<u>0</u>	<u>45</u>
<u>(mailing address)</u>	<u>clay</u>	<u>45</u>	<u>66</u>
WELL LOCATION:	<u>sand</u>	<u>66</u>	<u>70</u>
sec. <u>3</u> T. <u>7</u> S. R. <u>9</u> W.	<u>Clay-sand streaks</u>	<u>70</u>	<u>87</u>
<u>4</u> miles <u>NW</u> of <u>Biloxi</u>	<u>clay</u>	<u>87</u>	<u>90</u>
(distance) (direction) (nearest town)	<u>fine sand</u>	<u>90</u>	<u>98</u>
WELL PURPOSE: <u>HOME</u>	<u>clay</u>	<u>98</u>	<u>119</u>
(home, irrigation, municipal, industrial)	<u>sand</u>	<u>119</u>	<u>124</u>
WELL COMPLETION DATA:	<u>clay</u>	<u>124</u>	<u>179</u>
(1) diameter (inches) <u>2"</u>	<u>clay streaks</u>	<u>179</u>	<u>184</u>
(2) total depth (feet) <u>451'</u>	<u>fine sand</u>	<u>184</u>	<u>204</u>
(3) static water level (feet) <u>39</u> <sup>below</sup> / <sub>above</sub>	<u>clay</u>	<u>204</u>	<u>205</u>
(4) casing <u>galv.</u> <u>451'</u> (material) (depth)	<u>fine sand</u>	<u>205</u>	<u>215</u>
<u>✓</u> if telescope see back. (size)	<u>clay</u>	<u>215</u>	<u>221</u>
(5) screen <u>10'</u> <u>441'</u> (length) (depth to top)	<u>fine sand</u>	<u>221</u>	<u>236</u>
<u>008</u> <u>stainless steel</u> (size) (material)	<u>clay-sand mixed</u>	<u>236</u>	<u>259</u>
(6) pump <u>1/2</u> <u>g</u> (HP) (yield gpm)	<u>clay</u>	<u>259</u>	<u>285</u>
<u>Electric</u> (type power)	<u>fine sand</u>	<u>285</u>	<u>300</u>
(7) electric log <u>No</u> (yes or no)	<u>sand</u>	<u>300</u>	<u>310</u>
<u>✓</u> (organization running log)	<u>clay</u>	<u>310</u>	<u>321</u>
(8) how well bottom plugged <u>back</u> <u>pressure valve</u>	<u>clay + shell</u>	<u>321</u>	<u>361</u>
DRILLERS REMARKS:	<u>fine sand</u>	<u>361</u>	<u>407</u>
	<u>good sand</u>	<u>407</u>	<u>451</u>

CODED

If well telescopes please sketch and show depths.

GROUND LEVEL

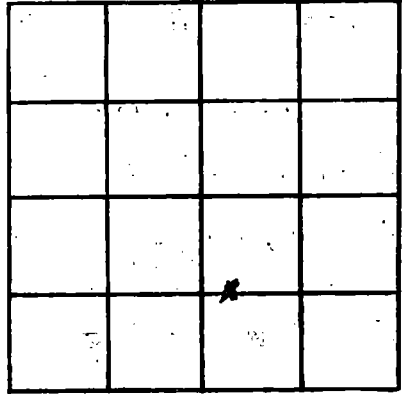

SECTION 3

Please indicate well location X.

ADDITIONAL INFORMATION

If more than one screen, show locations of each on sketch.