

JACKSON
~~NEW~~ 365
 1-28-72

MISSISSIPPI
 BOARD OF WATER COMMISSIONERS
 416 North State Street
 Jackson, Mississippi 39201

MAR 9 1972

CODED

WATER WELL DRILLERS LOG

1-28 1972 Switzer Well Co. JACKSON
 date well completed firm name county well located

LANDOWNER: Jony Adamo
Rt 3 Box 404
N. Biloxi, Miss. 39532
 (mailing address)

description of formations encountered	from	to
	Clay	0
SAND	134	139
SAND, FINE	139	159

WELL LOCATION:
 sec 11 T 7 S R 9 W
1 1/2 miles NE of Biloxi
 (distance) (direction) (nearest town)

WELL PURPOSE: home
 (home, irrigation, municipal, industrial)


WELL COMPLETION DATA:
 (1) diameter (inches) 2"
 (2) total depth (feet) 160'
 (3) static water level (feet) 12'6" below top of ground. above
 (4) casing galv. 160'
 (material) (depth)
 (size) if telescope see back.
 (5) screen 10' 150'
 (length) (depth to top)
008 stainless steel
 (size) (material)
 (6) pump NONE 7
 (HP) (yield gpm)
 (type power)
 (7) electric log No
 (yes or no)
 (organization running log)
 (8) how well bottom plugged back
pressure valve

CODED

DRILLERS REMARKS:

If well telescopes please sketch and show depths.

GROUND LEVEL

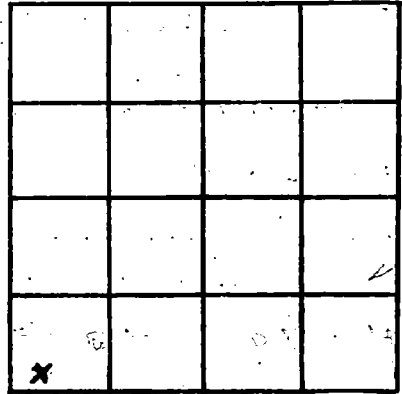

SECTION 11

Please indicate well location X.

ADDITIONAL INFORMATION

If more than one screen, show locations of each on sketch.