

# JACKSON

MISSISSIPPI  
 BOARD OF WATER COMMISSIONERS  
 416 North State Street  
 Jackson, Mississippi 39201

# CODED

## WATER WELL DRILLERS LOG

Aug. 19 19 67 Coast Water Well Service Harrison  
 date well completed firm name county well located

LANDOWNER E. F. Smith  
Rt. 3 Box 48A  
Boloxie Miss.  
 (mailing address)

WELL LOCATION:  
 sec. 3 T 2 N R 2 E  
7 miles N. West of Biloxi  
 (distance) (direction) (nearest town)

| description of formations encountered | from       | to         |
|---------------------------------------|------------|------------|
| <u>Coarse Sand</u>                    | <u>0</u>   | <u>20</u>  |
| <u>Blue Clay</u>                      | <u>20</u>  | <u>289</u> |
| <u>Fine Blue Sand</u>                 | <u>289</u> | <u>304</u> |
| <u>Blue Clay</u>                      | <u>304</u> | <u>351</u> |
| <u>Medium to Coarse Sand</u>          | <u>351</u> | <u>393</u> |

WELL PURPOSE: Home  
 (home, irrigation, municipal, industrial)

WELL COMPLETION DATA:

(1) diameter (inches) 2 in.

(2) total depth (feet) 393 ft.

(3) static water level (feet) 53 below top of ground.

(4) casing Galv. 383  
 (material) (depth)  
2 in. if telescope see back.  
 (size)


(5) screen 10 ft. 383  
 (length) (depth to top)  
10 slot, Plastic  
 (size) (material)

(6) pump 1/3 2.5  
 (HP) (yield gpm)  
Elect.  
 (type power)

(7) electric log no  
 (yes or no)  
N. A.  
 (organization running log)

(8) how well bottom plugged  
Backwash valve

# CODED

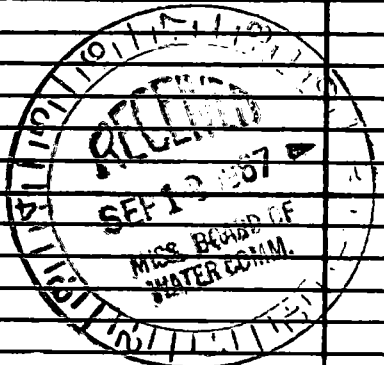

DRILLERS REMARKS:

