

halfway between
Racetrack & Lique Road

JACKSON

MISSISSIPPI
BOARD OF WATER COMMISSIONERS
416 North State Street
Jackson, Mississippi 39201

**CODED
JACKSON**

~~W-108~~
N 367
~~7-108~~

CODED

WATER WELL DRILLERS LOG

7-15 1968 Switzer Well Co. ~~Switzer~~
date well completed firm name county well located

LANDOWNER: Annie Flanagan

description of formations
encountered

from to

232 Reymair Road
Biloxi Miss 39532
(mailing address)

clay	0	20
sand	20	32
clay	32	42
mixed	42	102
clay	102	123
fine sand	123	143
mixed	143	205
fine sand	205	227
fair sand	227	268
good sand	268	288

WELL LOCATION:

sec. 15 T. 7 S. R. 9 W.
2 1/2 miles N of Biloxi
(distance) (direction) (nearest town)

WELL PURPOSE: Home
(home, irrigation, municipal, industrial)

WELL COMPLETION DATA:

(1) diameter (inches) 2

(2) total depth (feet) 288

(3) static water level (feet) 17 below
top of ground.

(4) casing gal steel 278'
(material) (depth)

2" If telescope see back.
(size)

(5) screen 10' 278'
(length) (depth to top)

8 ga. SS on pipe
(size) (material)

(6) pump Sears Roebuck
(HP) (yield gpm)

electric
(type power)


(7) electric log No
(yes or no)

(organization running log)

(8) how well bottom plugged Back
pressure valve


DRILLERS REMARKS:

**CODED
CODED**

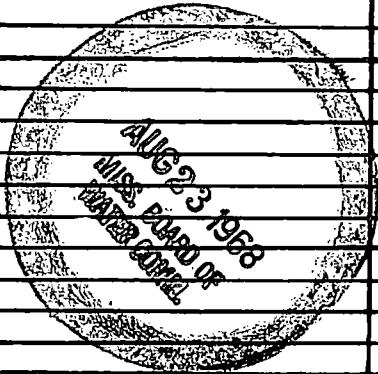

If well telescopes please sketch and show depths.

GROUND LEVEL

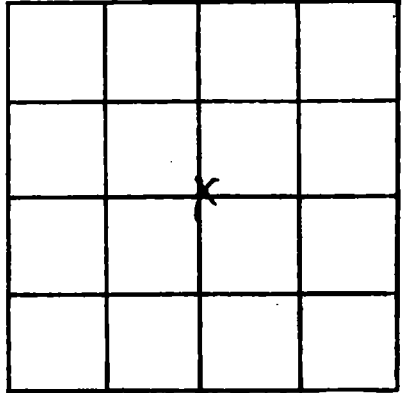

SECTION 15

Please indicate well location X.

ADDITIONAL INFORMATION

If more than one screen, show locations of each on sketch.