

JACKSON

MISSISSIPPI
BOARD OF WATER COMMISSIONERS
416 North State Street
Jackson, Mississippi 39201

CODED
JACKSON
~~Harrison~~
county well located


~~368~~
N 368
3-67

WATER WELL DRILLERS LOG

3-28 1967 Switzer Well Co. firm name
date well completed

LANDOWNER: <u>Milton Sibbles</u>	description of formations encountered	from	to
<u>NE corner Iruave + Goreyflo</u>	<u>clay</u>	<u>0</u>	<u>19</u>
	<u>sand</u>	<u>19</u>	<u>47</u>
<u>Box 210 Iruave Rd. Biloxi</u> (mailing address)	<u>clay</u>	<u>47</u>	<u>58</u>
	<u>fine blue sand</u>	<u>58</u>	<u>105</u>
	<u>med. coarse blue sand</u>	<u>105</u>	<u>121</u>
	<u>clay</u>	<u>121</u>	<u>147</u>
	<u>clay + sand streaks</u>	<u>147</u>	<u>164</u>
	<u>sand</u>	<u>164</u>	<u>169</u>
	<u>clay</u>	<u>169</u>	<u>331</u>
	<u>sand</u>	<u>331</u>	<u>335</u>
	<u>good sand</u>	<u>335</u>	<u>371</u>
WELL LOCATION:			
sec. <u>N 7</u> T. <u>7</u> R. <u>9</u> S. W. <u>BILOKI</u> 1 miles N of (distance) (direction) (nearest town)			
WELL PURPOSE: <u>home</u> (home, irrigation, municipal, industrial)			
WELL COMPLETION DATA:			
(1) diameter (inches) <u>2</u>			
(2) total depth (feet) <u>367</u>			
(3) static water level (feet) <u>12</u> below top of ground.			
(4) casing <u>gal. steel 357'</u> (material) (depth) <u>2"</u> (size) if telescope see back.			
(5) screen <u>10'</u> <u>357'</u> (length) (depth to top) <u>2"</u> <u>8ga SS on pipe</u> (size) (material)			
(6) pump <u>1/2</u> <u>8.5</u> (HP) (yield gpm) <u>electric</u> (type power)			
(7) electric log <u>No</u> (yes or no) (organization running log)			
(8) how well bottom plugged <u>back</u> <u>pressure valve</u>			
DRILLERS REMARKS:			

CODED

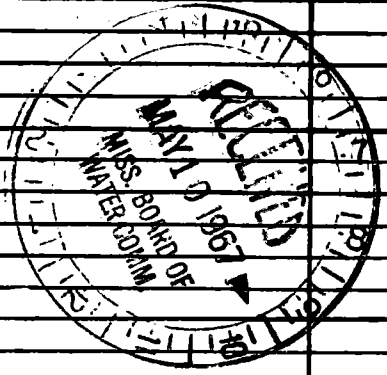

If well telescopes please sketch and show depths.

GROUND LEVEL

		X	

SECTION 15

Please indicate well location X.

ADDITIONAL INFORMATION

If more than one screen, show locations of each on sketch.