

JACKSON

~~Harrison~~

N 372

5-5-70

MISSISSIPPI  
BOARD OF WATER COMMISSIONERS  
416 North State Street  
Jackson, Mississippi 39201

CODED

3<sup>DB</sup> WATER WELL DRILLERS LOG

5/5/70  
date well completed

~~Central Wells Co.~~  
firm name

~~Harrison~~  
county well located

LANDOWNER: Bit. Seabright

description of formations encountered

from to

~~pt 2 Box 47 B~~  
~~Bluff Mills~~  
(mailing address)

top soil	1	5
white sand	5	15
glauca	15	25
shell	25	27
blue clay	27	20.5
fine white sand	20.5	220
blue clay	220	250
fine white sand	250	270
fine white sand	270	294

WELL LOCATION: 201

sec 24 T 7 N R 9 E

Back Bay Beloit  
miles (distance) (direction) (nearest town)

WELL PURPOSE: house  
(home, irrigation, municipal, industrial)

WELL COMPLETION DATA:

(1) diameter (inches) 2"

(2) total depth (feet) 294'

(3) static water level (feet) 27' below top of ground

(4) casing glau 284'  
(material) (depth)

(size) if telescope see back.

(5) screen 10' 284'  
(length) (depth to top)

2" (size) SS (material)

(6) pump 1 HP 21  
(HP) (yield gpm)

Elc  
(type power)

(7) electric log no  
(yes or no)

(organization running log)

(8) how well bottom plugged  
2" back wash valve

DRILLERS REMARKS:

Very good Well


CODED

JUN 11 1970

MISS. BD. OF  
WATER COM.

If well telescopes please sketch and show depths.

GROUND LEVEL

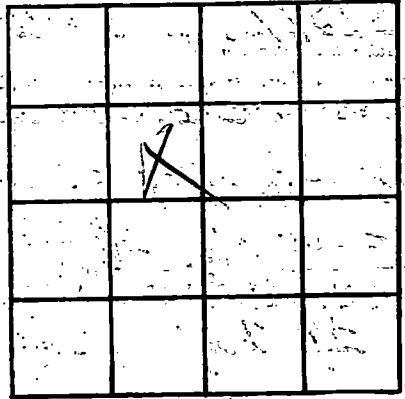

SECTION \_\_\_\_\_

Please indicate well location X.

ADDITIONAL INFORMATION

If more than one screen, show locations of each on sketch.