

JACKSON

4-14-72

MISSISSIPPI
BOARD OF WATER COMMISSIONERS
375 416 North State Street
Jackson, Mississippi 39201

CODED

WATER WELL DRILLERS LOG

10/24/70
date well completed

70 Coastal Path Co.
firm name

Harris
county well located

LANDOWNER: R.O. Wallace

description of formations encountered

from to

Rt 2 Box 148

Top Soil

1 3

Biloxi, Miss
(mailing address)

Red Clay

3 14

WELL LOCATION:

sec 3 T 7 N R 9 E
2 1/2 miles NW Biloxi
(distance) (direction) (nearest town)

White Sand

14 119

fine water sand

119 134

hard blue clay

134 310

fine water sand

310 362

hard blue clay

362 440

fine water sand

440 460

coarse water sand

460 500

WELL PURPOSE: house
(home, irrigation, municipal, industrial)

WELL COMPLETION DATA:

- (1) diameter (inches) 2"
- (2) total depth (feet) 500
- (3) static water level (feet) 34 below top of ground
- (4) casing glass, 490 (material) (depth)
- (5) screen 10' 490 (length) (depth to top)
2" 3.5 (size) (material)
- (6) pump 1 1/2 HP 15 (HP) (yield gpm)
Elev (type power)
- (7) electric log no (yes or no)

CODED

(organization running log)

(8) how well bottom plugged
2" backwash valve

DRILLERS REMARKS:


None

NOV 17 1970

MIC. DIV. OF
WATER COM.

If well telescopes please sketch and show depths.

GROUND LEVEL

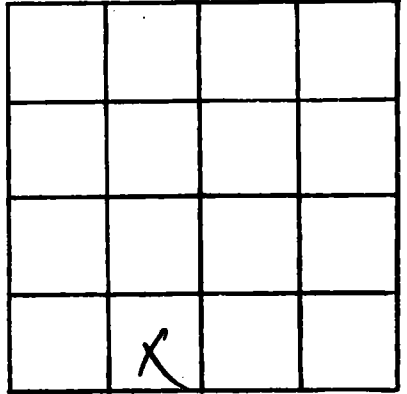

SECTION _____

Please indicate well location X.

ADDITIONAL INFORMATION

If more than one screen, show locations of each on sketch.