

JACKSON

~~HARRISON~~

N 378 ~~111111~~

3-23-71

MISSISSIPPI
BOARD OF WATER COMMISSIONERS
416 North State Street
Jackson, Mississippi 39201

CODED

WATER WELL DRILLERS LOG

March 23 1971

C.T. Switzer Well Co.

Harrison

date well completed

firm name

county well located

LANDOWNER: Joseph W. Freeman

321 Seymour Ave.

Biloxi, Miss. 39531

(mailing address)

WELL LOCATION:

sec. 15 T 7 S R 9 W

1 miles NE of Biloxi
(distance) (direction) (nearest town)

WELL PURPOSE:

HOME
(home, irrigation, municipal, industrial)

WELL COMPLETION DATA:

- (1) diameter (inches) 2"
- (2) total depth (feet) 149'
- (3) static water level (feet) 6' below top of ground.
- (4) casing galv., 149'
(material) (depth)

 if telescope see back.
(size)

- (5) screen 10', 139'
(length) (depth to top)
006, stainless steel
(size) (material)

- (6) pump 1, 11
(HP) (yield gpm)
Electric
(type power)

- (7) electric log No
(yes or no)

(organization running log)

- (8) how well bottom plugged back
pressure valve

DRILLERS REMARKS:

description of formations encountered

from

to

CLAY

0

12

SAND

12

21

SAND + GRAVEL

21

23

CLAY

23

124

SAND, FINE

124

149


CODED

APR - 9 1971

MISS. BD. OF
WATER COMM.

If well telescopes please sketch and show depths.

GROUND LEVEL

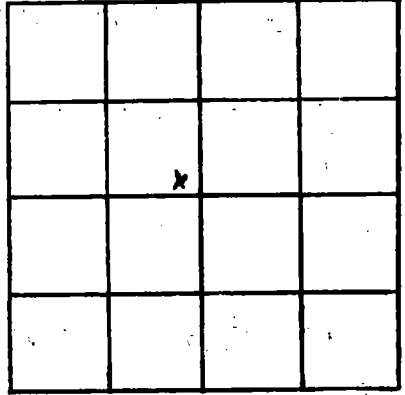

SECTION 15

Please indicate well location X.

ADDITIONAL INFORMATION

If more than one screen, show locations of each on sketch.