

JACKSON

MISSISSIPPI  
BOARD OF WATER COMMISSIONERS  
416 North State Street  
Jackson, Mississippi 39201

**CODED**

WATER WELL DRILLERS LOG

Switzer Well Co.

Harrison

5-14-1971  
date well completed

firm name

county well located

LANDOWNER: Louis Bessette

Third Street

Biloxi Miss. 39531  
(mailing address)

WELL LOCATION:

sec. 16 T 7 S R 9 W

(distance) miles (direction) of (nearest town)

WELL PURPOSE: home  
(home, irrigation, municipal, industrial)

WELL COMPLETION DATA:

- (1) diameter (inches) 2"
- (2) total depth (feet) 185'
- (3) static water level (feet) 13' below top of ground
- (4) casing GALV. 185' (material), (depth), (size) If telescope see back.
- (5) screen 10' 175' (length), (depth to top) 008 stainless steel (size), (material)
- (6) pump NONE (HP) (yield gpm) (type power)
- (7) electric log NO (yes or no) (organization running log)

(8) how well bottom plugged back pressure valve

description of formations encountered

from	to
0	15
15	21
21	95
95	100
100	130
130	140
140	164
164	179
179	199


**CODED**

JUN 23 1971

DRILLERS REMARKS:

If well telescopes please sketch and show depths.

GROUND LEVEL

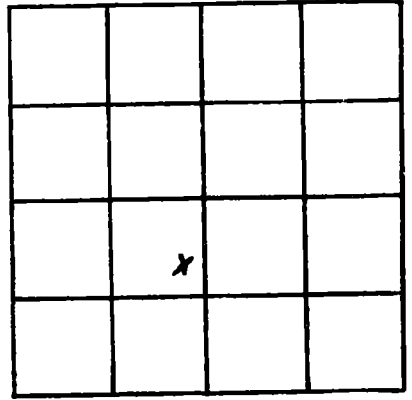

SECTION 16

Please indicate well location X.

ADDITIONAL INFORMATION

If more than one screen, show locations of each on sketch.