

JACKSON

N 381

12-28-72

MISSISSIPPI
BOARD OF WATER COMMISSIONERS
416 North State Street
Jackson, Mississippi 39201

WATER WELL DRILLERS CODED

CODED

12-28 1972 Switzer Well Company Jackson
date well completed firm name county well located

LANDOWNER Cand Waters

description of formations encountered

from

to

(Blue Hills well)

Clay

0

26

120 Pass Rd.
Biloxi, Miss. 39531
(mailing address)

sand

26

34

sand + gravel

34

54

Sand

54

57

WELL LOCATION:

Clay

57

80

sec. 13 T. 7 S. R. 9 W.

Sand

80

86

mud

86

97

1 1/2 miles NW of Pope Springs
(distance) (direction) (nearest town)

Clay

97

121

sand

121

124

WELL PURPOSE: Subdivision
(home, irrigation, municipal, industrial)

Clay

124

196

mud

196

206

Clay

206

295

WELL COMPLETION DATA:

mud

295

305

(1) diameter (Inches) 6"

Clay

305

421

(2) total depth (feet) 874'

sand

421

430

(3) static water level (feet) 7' (below/above top of ground)

Clay

430

435

(4) casing galv. 874'
(material) (depth)

sand

430

435

10 if telescope see back.
(size)

Clay

435

457

(5) screen 60' 814'
(length) (depth to top)

mud

457

475

008, Stainless steel
(size) (material)

fine sand

475

495

(6) pump 25 250
(HP) (yield gpm)

good sand

495

498

Electric
(type power)

Sand

498

608

(7) electric log NP
(yes or no)

Clay

608

615

(organization running log)

sand

615

653

How well bottom plugged check
Crack Water

Clay

653

663

mud

663

696

Clay

696

699

sand

699

751

Clay

751

761

Sand, fine

761

874



sand, fair

DRILLERS REMARKS:

MS 4 10 1973
MS 12 1973

If well telescopes please sketch and show depths.

GROUND LEVEL

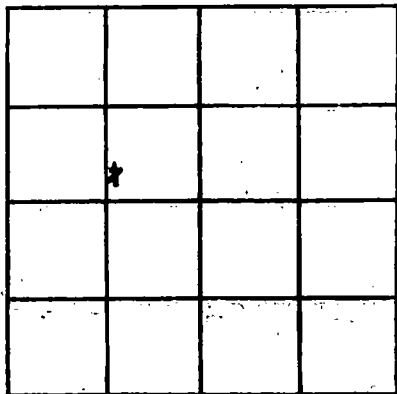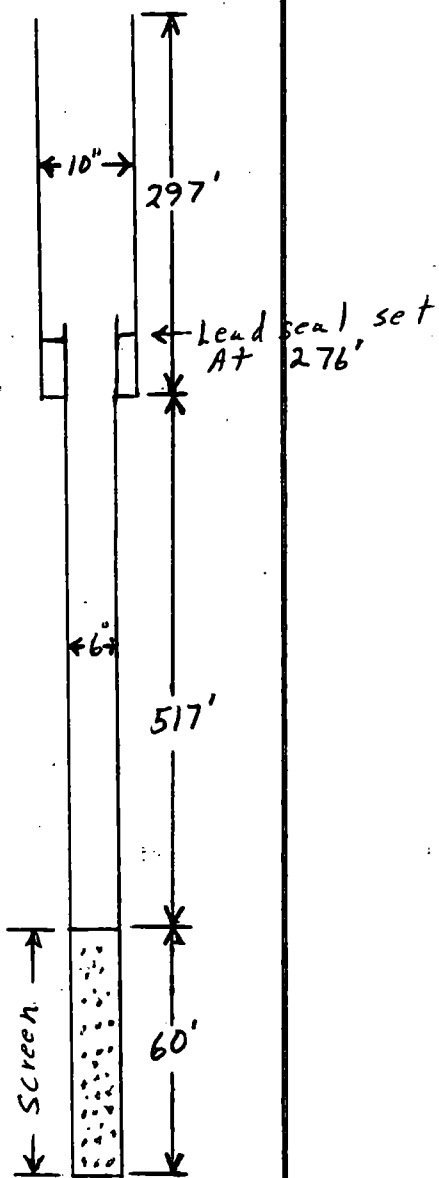

SECTION 13

Please indicate well location X.

ADDITIONAL INFORMATION

If more than one screen, show locations of each on sketch.