

JACKSON

~~HARRISON~~

~~MISSISSIPPI~~

11-17-71

MISSISSIPPI
BOARD OF WATER COMMISSIONERS
382 416 North State Street
Jackson, Mississippi 39201

coded

WATER WELL DRILLERS LOG

JACKSON

~~Mississippi~~

11-17 1971
date well completed

Switzer Well Co.
firm name

county well located

LANDOWNER: First Miss. Nat. Bank
Branch
US Hwy 67
North Biloxi, Miss. 39532
(mailing address)

WELL LOCATION:
sec 16 T 7 S R 9 W
1 miles N of Biloxi
(distance) (direction) (nearest town)

WELL PURPOSE: BANK
(home, irrigation, municipal, industrial)



WELL COMPLETION DATA:
(1) diameter (inches) ~~8 1/2~~ 2"
(2) total depth (feet) 878'
(3) static water level (feet) 3'4" below top of ground
(4) casing Galv. 878' (material) (depth)
4 (size) if telescope see back.
(5) screen 20' 858' (length) (depth to top)
008, stainless steel (size) (material)
(6) pump 1/2 20 (HP) (yield gpm)
Electric (type power)
(7) electric log NO (yes or no)
(organization running log)
(8) how well bottom plugged back pressure valve

description of formations encountered	from	to
sand-gravel mixed	0	23
clay	23	82
sand	82	113
clay	113	145
sand	145	165
clay	165	166
sand	166	242
clay	242	257
clay-shale mixed	257	279
clay	279	385
sand	385	403
clay	403	535
clay sand streaks	535	578
clay	578	641
sand	641	646
clay	646	668
clay shale	668	684
clay	684	699
sand	699	705
clay	705	785
sand	785	878

DRILLERS REMARKS:

If well telescopes please sketch and show depths.

GROUND LEVEL

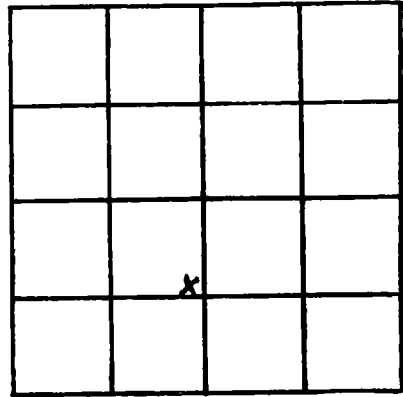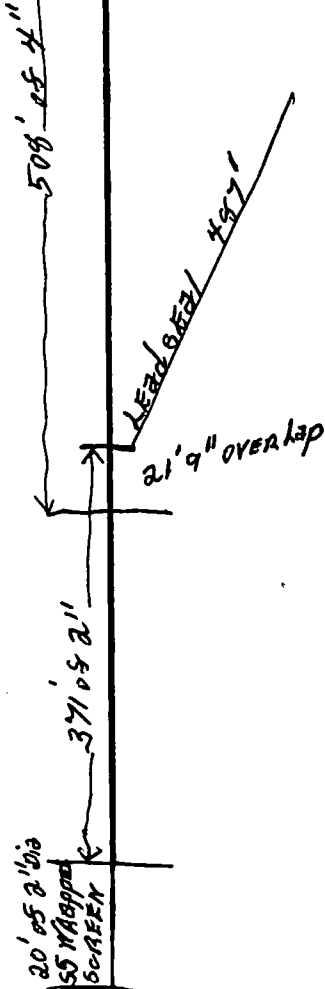

SECTION 16

Please indicate well location X.

ADDITIONAL INFORMATION

Lined area for additional information.

If more than one screen, show locations of each on sketch.