

JACKSON

Harrison

N 3983

6-67

MISSISSIPPI BOARD OF WATER COMMISSIONERS
416 North State Street
Jackson, Mississippi 39201

CODED

WATER WELL DRILLERS LOG

6-26-67
date well completed

1967 Switzer Well Co.
firm name

Harrison
county well located

LANDOWNER: J. A. Rodriguez

description of formations encountered

from to

206 Lemoyne Blvd.

clay

0 43

Beloxi, Mississippi
(mailing address)

fine sand

43 64

sand + clay

64 85

clay

85 106

WELL LOCATION:

clay + sand streaks

106 126

sec. 16 T. 7 R. 9
S W
2 miles N of Beloxi
(distance) (direction) (nearest town)

fine sand

126 166

good sand

166 199

WELL PURPOSE: Home
(home, irrigation, municipal, industrial)

WELL COMPLETION DATA:

- (1) diameter (inches) 2
- (2) total depth (feet) 198
- (3) static water level (feet) 10 below top of ground.

CODED

- (4) casing gal. steel, 188'
(material) (depth)

2" if telescope see back.
(size)

- (5) screen 10', 188'
(length) (depth to top)

8 ga., SS on pipe
(size) (material)

- (6) pump 1/2, 8.5
(HP) (yield gpm)


electric
(type power)

- (7) electric log No
(yes or no)

(organization running log)


- (8) how well bottom plugged Back pressure valve

DRILLERS REMARKS:

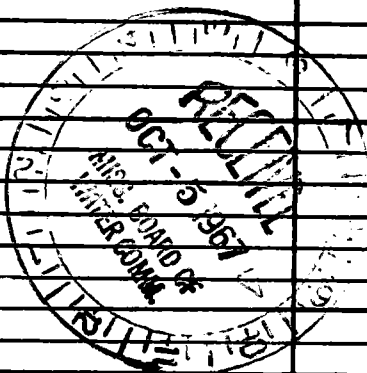

If well telescopes please sketch and show depths.

GROUND LEVEL

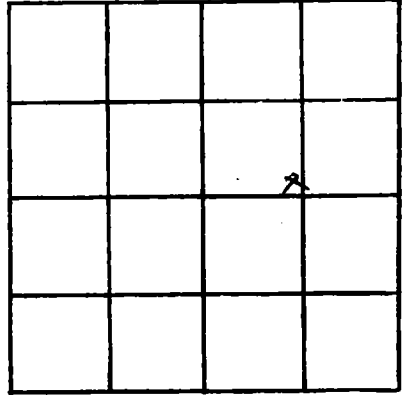

SECTION 16

Please indicate well location X.

ADDITIONAL INFORMATION

If more than one screen,
show locations of each on sketch.