

JACKSON

~~Harrison~~

~~N 2113~~ 384

7-69

MISSISSIPPI
 BOARD OF WATER COMMISSIONERS
 416 North State Street
 Jackson, Mississippi 39201

CODED

WATER WELL DRILLERS LOG

7-22-1967 Switzer Well Co Harrison
 date well completed firm name county well located

LANDOWNER Alfred Thibodeaux

description of formations encountered

from to

197 Reynard Road

clay

0 22

Biloxi, Miss.

sand

22 37

(mailing address)

clay

37 41

WELL LOCATION:

Sand & gravel

41 62

sec. 16 T 2 S R 9 E
1 miles N. of Biloxi
 (distance) (direction) (nearest town)

Sand & clay streaks

62 122

clay

122 143

Sand & clay streaks

143 164

clay

164 206

Sand & clay streaks

206 227

clay

227 248

WELL PURPOSE: Home
(home, irrigation, municipal, industrial)

fine sand

248 269

WELL COMPLETION DATA:

good sand

269 290

(1) diameter (inches) 2

clay

290 318

(2) total depth (feet) 355

sand

318 328

(3) static water level (feet) 18 below top of ground.

good sand

328 355

(4) casing gal. steel 345'
(material) (depth)

2" If telescope see back.
(size)

(5) screen 10' 345'
(length) (depth to top)

800 ss on pipe
(size) (material)

(6) pump not installed
(HP) (yield gpm)

(type power)


(7) electric log no
(yes or no)

(organization running log)

(8) how well bottom plugged Back pressure valve

DRILLERS REMARKS:

CODED

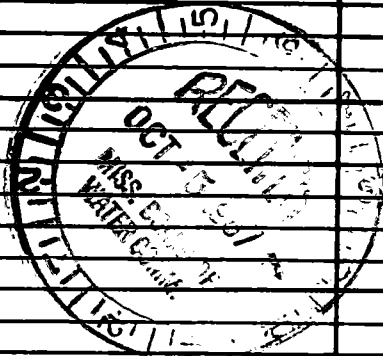

If well telescopes please sketch and show depths.

*

GROUND LEVEL

			X

SECTION 16

Please indicate well location X.

ADDITIONAL INFORMATION

If more than one screen, show locations of each on sketch.