

JACKSON  
 N 393  
 3-1-72

MISSISSIPPI  
 BOARD OF WATER COMMISSIONERS  
 416 North State Street  
 Jackson, Mississippi 39201

**CODED**

WATER WELL DRILLERS LOG

*Jackson*  
~~Mississippi~~

3/1/72  
 date well completed

19 *Coastal Drilling Co.*  
 firm name

county well located

LANDOWNER:

*H. D. Hunt*

*1102 East Bay View*  
*Biloxi, Miss*  
 (mailing address)

WELL LOCATION:

sec. *14* T. *7* N. R. *9* E  
*1 1/2* miles *West Gulf Hill*  
 (distance) (direction) (nearest town)

WELL PURPOSE:

*Home*  
 (home, irrigation, municipal, industrial)

WELL COMPLETION DATA:

- (1) diameter (inches) *2"*
- (2) total depth (feet) *787*
- (3) static water level (feet) *1* below above top of ground.
- (4) casing *Galv.* *777*  
 (material) (depth)  
 (size) if telescope see back.
- (5) screen *10'* *777*  
 (length) (depth to top)  
*2"* *SS*  
 (size) (material)
- (6) pump *one* *27*  
 (HP) (yield gpm)  
*Elec*  
 (type power)
- (7) electric log *no*  
 (yes or no)

(organization running log)

(8) how well bottom plugged *2"*

DRILLERS REMARKS:

*Very good well*

description of formations encountered

	from	to
<i>Top Soil</i>	<i>1</i>	<i>3</i>
<i>Red Sand</i>	<i>3</i>	<i>8</i>
<i>Brown Sand</i>	<i>8</i>	<i>15</i>
<i>Slaves</i>	<i>15</i>	<i>27</i>
<i>Super Sand</i>	<i>27</i>	<i>60</i>
<i>O. Blue Clay</i>	<i>60</i>	<i>230</i>
<i>Shells</i>	<i>230</i>	<i>235</i>
<i>hard Blue Clay</i>	<i>235</i>	<i>504</i>
<i>fine water sand</i>	<i>504</i>	<i>520</i>
<i>Shells</i>	<i>520</i>	<i>522</i>
<i>very hard blue clay</i>	<i>522</i>	<i>705</i>
<i>fine water sand</i>	<i>705</i>	<i>725</i>
<i>Coarse water sand</i>	<i>725</i>	<i>787</i>


**CODED**



If well telescopes please sketch and show depth.

010000

GROUND LEVEL

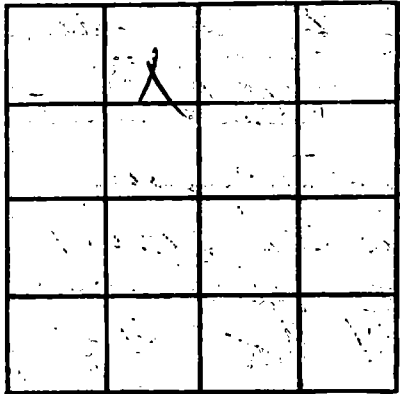

SECTION \_\_\_\_\_

Please indicate well location X.

ADDITIONAL INFORMATION

A series of horizontal lines for writing additional information, starting below the 'ADDITIONAL INFORMATION' header and extending to the bottom of the page.

010000

If more than one screen, show locations of each on sketch.