

**JACKSON**  
**N 395**  
**7-1-72**

MISSISSIPPI  
 BOARD OF WATER COMMISSIONERS  
 416 North State Street  
 Jackson, Mississippi 39201

**CODED**

**WATER WELL DRILLERS LOG**

7-1 1972 J.T. WARD WATER WELLS Jackson  
 date well completed firm name county well located

LANDOWNER: Jack Marshall  
Green Thumb Nursery  
Ocean Springs, Miss  
 (mailing address)

| description of formations encountered | from | to  |
|---------------------------------------|------|-----|
| top soil & clay                       | 0    | 25  |
| sand                                  | 25   | 33  |
| clay                                  | 33   | 112 |
| sand                                  | 112  | 131 |
| clay                                  | 131  | 213 |
| sandy clay                            | 213  | 237 |
| sand                                  | 237  | 259 |
| blue clay                             | 259  | 281 |
| sand                                  | 281  | 290 |
| clay                                  | 290  | 316 |
| sand                                  | 316  | 327 |
| clay                                  | 327  | 448 |
| sand                                  | 448  | 523 |

WELL LOCATION:  
 sec. 25 T. 7 N. R. 8 E.  
7 miles E of Ocean Springs  
 (distance) (direction) (nearest town)

WELL PURPOSE: irrigation  
 (home, irrigation, municipal, industrial)


- WELL COMPLETION DATA:
- (1) diameter (inches) 2"
  - (2) total depth (feet) 503'
  - (3) static water level (feet) 488' below top of ground.
  - (4) casing 2" galv. 488'  
 (material) (depth)
  - (size) if telescope see back.
  - (5) screen 20' 2"  
 (length) (depth to top) (size) (material)
  - (6) pump 1 1/2 12  
 (HP) (yield gpm)  
Electric  
 (type power)
  - (7) electric log NO  
 (yes or no)
  - (organization running log)
  - (8) how well bottom plugged BWV

**CODED**


**MSG** 7 1972

DRILLERS REMARKS:

If well telescopes please sketch and show depth

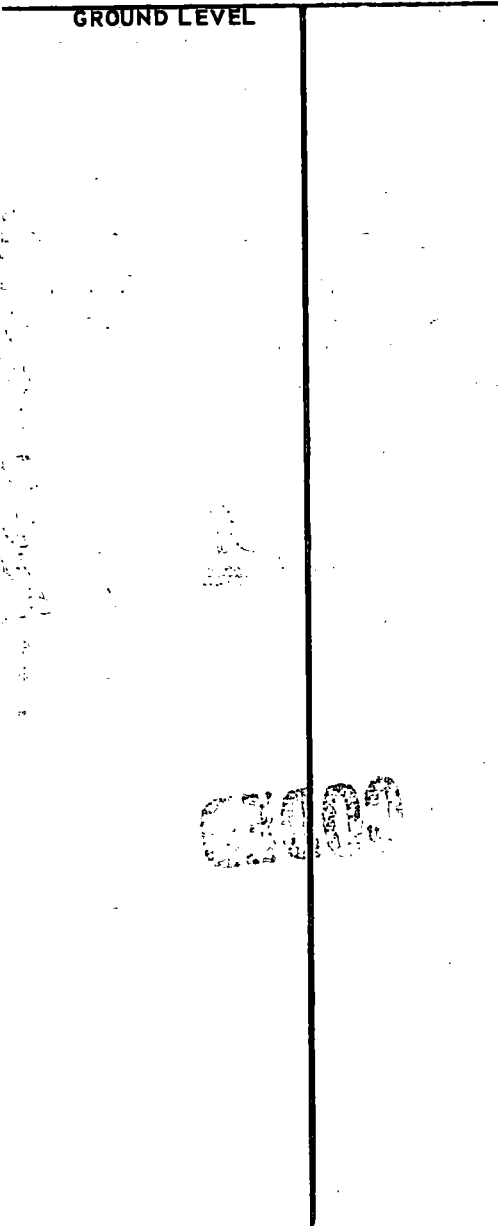

GROUND LEVEL

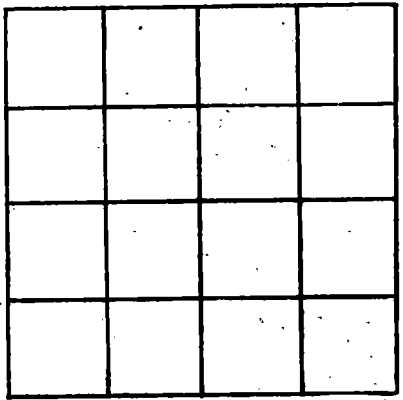

SECTION \_\_\_\_\_

Please indicate well location X.

ADDITIONAL INFORMATION

Lined area for additional information, consisting of approximately 20 horizontal lines.

If more than one screen, show locations of each on sketch.