

JACKSON
 N 398
 7-28-72

MISSISSIPPI
 BOARD OF WATER COMMISSIONERS
 416 North State Street
 Jackson, Mississippi 39201

WATER WELL DRILLERS LOG

CODED

7-28 1972 Switzer Well Company firm name
 date well completed county well located

LANDOWNER: Joseph Milstead
 Seaman Road
 Ocean Springs, Miss.
 (mailing address)

WELL LOCATION:
 sec. 1 T. 7 S. R. 9 W.
 4 miles N of Ocean Springs
 (distance) (direction) (nearest town)

WELL PURPOSE: none
 (home, irrigation, municipal, industrial)

WELL COMPLETION DATA:

(1) diameter (inches) 2"

(2) total depth (feet) 456'

(3) static water level (feet) 43' ^{below} / _{above} top of ground.

(4) casing galv. / stainless steel
 (material) (depth) 456'

(size) If telescope see back.

(5) screen 10' / 446'
 (length) (depth to top)

008 / stainless steel
 (size) (material)

(6) pump 1/2 / 8
 (HP) (yield gpm)

ELECT /
 (type power)

(7) electric log - No /
 (yes or no)

(organization running log)

(8) how well bottom plugged back
 pressure value

description of formations encountered	from	to
Sand	0	14
Clay	14	45
Sand	45	66
Sand-clay mixed	66	87
Clay-sand mixed	87	108
Sand	108	114
Clay	114	129
Sand	129	194
sand, fine	194	209
Clay	209	215
Sand, fine	215	236
Clay	236	257
Clay-sand str.	257	278
Clay	278	318
Sand	318	321
Clay	321	385
Clay-sand str.	385	406
Clay	406	418
Sand, fine	418	428
Sand, good	428	456

CODED


SEP 5 1972

MISS. Bd. of WATER COMMISSIONERS

DRILLERS REMARKS:

If well telescopes please
sketch and show depths.

GROUND LEVEL

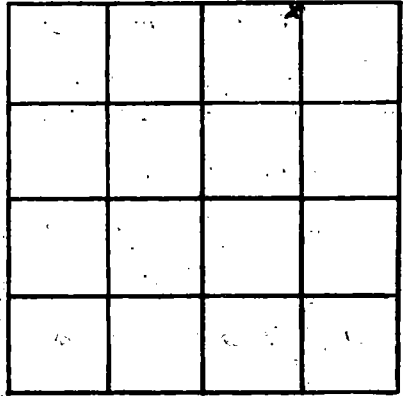

SECTION 1

Please indicate well location X.

ADDITIONAL INFORMATION

If more than one screen,
show locations of each on sketch.